

STATE OF KANSAS
STATE CORPORATION COMMISSION


15-039-20469-00-00

WELL PLUGGING RECORD

Give All Information Completely
Make Required Affidavit
Mail or Deliver Report to
Conservation Division
State Corporation Comm.
245 North Water
Wichita, KS 67202

Decatur County, Sec. 28 Twp. 2S Rge. 30W E/W
Location as "NE/CNW 1/4 SW 1/4" or footage from lines
SW SW NE

Lease Owner Hummon Corporation
Lease Name Helmcamp Well No. 1
Office Address 400 One Main Place, Wichita, Ks. 67202
Character of Well (Completed as Oil, Gas or Dry Hole) Dry Hole

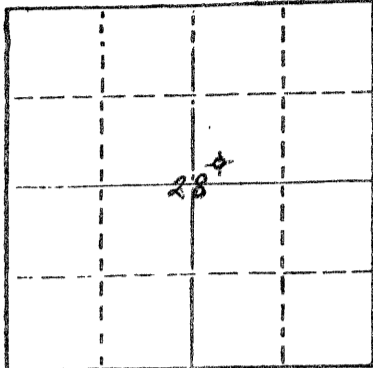

Locate well correctly on above
Section Plat

Date Well completed December 3, 1979
Application for plugging filed December 3, 1979
Application for plugging approved December 3, 1979
Plugging commenced December 3, 1979
Plugging completed December 3, 1979
Reason for abandonment of well or producing formation Dry Hole

If a producing well is abandoned, date of last production 19__

Was permission obtained from the Conservation Division or its agents before plugging was commenced? Yes

Name of Conservation Agent who supervised plugging of this well Gil Balthazor
Producing formation _____ Depth to top _____ Bottom _____ Total Depth of Well 4403'
Show depth and thickness of all water, oil and gas formations.

OIL, GAS OR WATER RECORDS

CASING RECORD

FORMATION	CONTENT	FROM	TO	SIZE	PUT IN	PULLED OUT
		0	320'	8-5/8"	313.05'	None

Describe in detail the manner in which the well was plugged, indicating where the mud fluid was placed and the method or methods used in introducing it into the hold. If cement or other plugs were used, state the character of same and depth placed, from _____ feet to _____ feet for each plug set.

Plugged with 70 sacks cement at 1680',
20 sacks cement at 300', 1/2 sack hulls
and 10 sacks cement at 40', and 5 sacks
cement in rat hole.

RECEIVED
STATE CORPORATION COMMISSION
12-26-1979
DEC 26 1979
CONSERVATION DIVISION
Wichita, Kansas

(If additional description is necessary, use BACK of this sheet)

Name of Plugging Contractor Halliburton Cementing Co.

STATE OF KANSAS COUNTY OF SEDGWICK, ss.
John D. Knightley Agent (employee of owner) or (owner or operator)
of the above-described well, being first duly sworn on oath, says: That I have knowledge of the facts, statements, and matters herein contained and the log of the above-described well as filed and that the same are true and correct. So help me God.

(Signature) [Signature]
221 S. Broadway, Wichita, Kansas 67202
(Address)

SUBSCRIBED AND SWORN TO before me this 21st day of December, 1979

[Signature]
Notary Public.
My commission expires March 12, 1983

NOTARY PUBLIC
WICHITA, KANSAS

15-039-20469-00-00

Hummon Corporation
400 One Main Place
Wichita, Kansas 67202

Helmcamp #1
SW SW NE Sec. 28-2S-30W
Decatur County, Kansas

Contractor: D. R. Lauck Oil Company, Inc.
221 S. Broadway, Suite 400
Wichita, Kansas 67202

Commenced: November 23, 1979
Completed: December 3, 1979

Drillers Log

Shale	2220
Shale & Shells	2687
Anhydrite	2719
Shale & Shells	2930
Shale & Lime	3936
Lime	4403 RTD

RECEIVED
STATE CORPORATION COMMISSION

DEC 26 1979

CONSERVATION DIVISION
Wichita, Kansas