


WELL PLUGGING RECORD

Give All Information Completely  
Make Recorded Affidavit  
Mail or Deliver Report to:  
Conservation Division  
State Corporation Commission  
211 No. Broadway  
Wichita, Kansas

NORTH

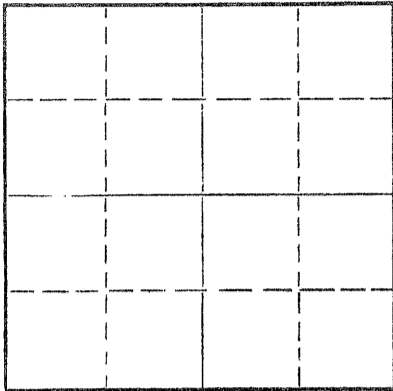

Locate well correctly on above  
Section Plat

Rawlins County, Sec. 13 Twp. 28 Rge. 32 (X) (W)  
Location as "NE/CNW%SW%" or footage from lines C NW NW  
Lease Owner Leben Drilling, Inc.  
Lease Name Heyen Well No. 1  
Office Address P.O. Box 486 Great Bend, Kansas  
Character of Well (completed as Oil, Gas or Dry Hole) Dry Hole  
Date well completed 7-17-61 19  
Application for plugging filed 7-17-61 19  
Application for plugging approved 7-17-61 19  
Plugging commenced 7-17-61 19  
Plugging completed 7-17-61 19  
Reason for abandonment of well or producing formation Dry Hole

If a producing well is abandoned, date of last production \_\_\_\_\_ 19\_\_\_\_  
Was permission obtained from the Conservation Division or its agents before plugging was commenced? Yes

Name of Conservation Agent who supervised plugging of this well Eldon Petty  
Producing formation \_\_\_\_\_ Depth to top \_\_\_\_\_ Bottom \_\_\_\_\_ Total Depth of Well 4280' Feet  
Show depth and thickness of all water, oil and gas formations.

OIL, GAS OR WATER RECORDS

CASING RECORD

FORMATION	CONTENT	FROM	TO	SIZE	PUT IN	PULLED OUT
				8 5/8"	254'	None

Describe in detail the manner in which the well was plugged, indicating where the mud fluid was placed and the method or methods used in introducing it into the hole. If cement or other plugs were used, state the character of same and depth placed, from \_\_\_\_\_ feet to \_\_\_\_\_ feet for each plug set.

1st Plug @ 600' w/20 sks cement  
2nd Plug @ 240' w/20 sks cement  
3rd Plug @ 40' w/10 sks cement

RECEIVED  
STATE CORPORATION COMMISSION

AUG 14 1961

CONSERVATION DIVISION  
Wichita, Kansas

8-14-61

(If additional description is necessary, use BACK of this sheet)

Name of Plugging Contractor Leben Drilling, Inc.  
Address P.O. Box 486 Great Bend, Kansas

STATE OF Kansas, COUNTY OF Barton, ss.  
Byron Johnson

(employee of owner) or (owner or operator) of the above-described well, being first duly sworn on oath, says: That I have knowledge of the facts, statements, and matters herein contained and the log of the above-described well as filed and that the same are true and correct. So help me God.

(Signature) Byron Johnson  
P.O. Box 486 Great Bend, Kansas  
(Address)

SUBSCRIBED AND SWORN TO before me this 21 day of July, 19 61

My commission expires April 1, 1961

Ulanda Nichols  
Ulanda Nichols  
Notary Public.



CONTRACT NO.  
 CONTRACTOR:  
 FIRM:  
 LOCATION:  
 COMMENCED:  
 COMPLETED:

Leben Drilling, Inc.  
 Leavenworth, Kan.  
 HAYEN #1  
 C. NW. NW. 34, 13-28-11W  
 BARTON COUNTY, KANSAS  
 7-1-61  
 7-15-61

0	70	Shale
70	150	Shale
150	190	Sand
190	215	Clay
215	237	Blue Shale
237	254	Sand & Shale
254	1975	Sand & Shale
1975	2480	Shale & Lime
2480	2735	Lime & Shale
2735	3805	Lime
3805	3985	Lime & Shale
3985	4060	Lime
4060	4165	Lime & Shale
4165	4255	Lime
4255	4280	Lime
	4280	Rotary Total Depth - D & A

Set 8 5/8" casing @ 25L\* with 175 sx HA5.

I, Byron Johnson, do hereby certify that the above and foregoing is a true and correct copy of the log of the Hayen #1, located C. NW. NW. of Section 13, Township 2 South, Range 32 West, Barton County, Kansas, as reflected by the files of Leben Drilling, Inc.

*Byron Johnson*  
 Byron Johnson  
 RECEIVED  
 STATE CORPORATION COMMISSION  
 AUG 14 1961  
 CONSERVATION DIVISION  
 WICHITA, KANSAS  
 8-14-61

STATE OF KANSAS )  
 ) 38  
 COUNTY OF BARTON )

Subscribed and sworn to before me, a Notary Public, in and for Barton County, Kansas, this 21st day of July, 1961.

Ulanda Nichols

My Commission Expires  
 April 1, 1963