


STATE OF KANSAS  
STATE CORPORATION COMMISSION

Give All Information Completely  
Make Required Affidavit  
Mail or Deliver Report to:  
Conservation Division  
State Corporation Commission  
211 No. Broadway  
Wichita, Kansas

15-153-30112-00-00

WELL PLUGGING RECORD

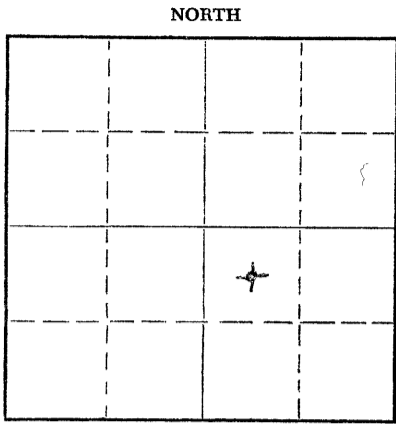

Locate well correctly on above  
Section Plat

Rawlins County, Sec. 3 Twp. 2S Rge. (E) 32 (W)  
Location as "NE/CNW/SW" or footage from lines NW SE  
Lease Owner Graybol Oil Corporation  
Lease Name NEMETH Well No. 1  
Office Address 2200 N.B.T. Building, Tulsa 3, Oklahoma  
Character of Well (completed as Oil, Gas or Dry Hole) Dry Hole  
Date well completed June 26 19 63  
Application for plugging filed June 26 19 63  
Application for plugging approved June 26 19 63  
Plugging commenced June 27 19 63  
Plugging completed June 27 19 63  
Reason for abandonment of well or producing formation Dry Hole

If a producing well is abandoned, date of last production \_\_\_\_\_ 19 \_\_\_\_  
Was permission obtained from the Conservation Division or its agents before plugging was commenced? Yes

Name of Conservation Agent who supervised plugging of this well W. L. Nichols, Moreland, Kansas  
Producing formation None Depth to top \_\_\_\_\_ Bottom \_\_\_\_\_ Total Depth of Well 4509 Feet  
Show depth and thickness of all water, oil and gas formations.

OIL, GAS OR WATER RECORDS

CASING RECORD

FORMATION	CONTENT	FROM	TO	SIZE	PUT IN	PULLED OUT
Topeka	Water	3650	3677	8 5/8"	261	None
Oread Lime	Water	3750	3770			
Lansing Lime	Water	3797	4058			
Conglomerate	Water	4363	4404			
Arbuckle Lime	Water	4404	4490			
Granite Wash & Granite	Impermeable	4490	4509			

Describe in detail the manner in which the well was plugged, indicating where the mud fluid was placed and the method or methods used in introducing it into the hole. If cement or other plugs were used, state the character of same and depth placed, from \_\_\_\_\_ feet to \_\_\_\_\_ feet for each plug set.

Filled hole with heavy mud-laden fluid. Pushed plug to 600'. Cemented with 20 sacks of Portland cement. Placed plug at 255'. Cemented with 20 sacks of Portland cement. Placed plug at 40'. Filled hole with 10 sacks of Portland cement from 40' to ground level. Plugging completed at 8:00 A.M. June 27, 1963.

RECEIVED  
STATE CORPORATION COMMISSION

JUL 1 1963

7-1-63

CONSERVATION DIVISION  
Wichita, Kansas

(If additional description is necessary, use BACK of this sheet)

Name of Plugging Contractor Graybol Oil Corporation  
Address 2200 National Bank of Tulsa Bldg., Tulsa, Oklahoma

STATE OF Oklahoma, COUNTY OF Tulsa, ss.  
Lyman C. Dennis (employee of owner) or (owner/operator) of the above-described well, being first duly sworn on oath, says: That I have knowledge of the facts, statements, and matters herein contained and the log of the above-described well as filed and that the same are true and correct. So help me God.

(Signature) Lyman C. Dennis  
Tulsa, Oklahoma  
(Address)

SUBSCRIBED AND SWORN TO before me this 28th day of June, 19 63

My commission expires October 8, 1966

Jan Carrigan  
Notary Public.

INVOICED  
DATE 7/1/63  
INV. NO. 7330-W

15-193-30112-00-00

Graybol Oil Corporation

Rawlins County, Kansas

No. 1 Nemeth

NW SE Section 3-2S-32W

Contractor: Company Tools

Elev: 2871' D.F., 2865' G.L.

Commenced: June 14, 1963

Completed: June 26, 1963

Production: Dry & Abandoned

CASING RECORD

Set 8 5/8" Casing @ 261# with 165 sacks of cement.

Depth	Formation	Welex Electric Log Tops
0-37	Surface Clay and Sand	Niobrara 710
37-190	Shale and Sand	Greenhorn 1462
190-865	Shale	Dakota 1587
865-1920	Shale and Sand	Morrison 2165
1920-2265	Sand and Shale	Permian-Blaine Anhy. 2402
2265-2405	Gyp and Shale	Stone Corral Anhy. 2623
2405-2623	Shale	Topeka 3650
2623-2660	Anhydrite	Oread 3750
2660-2815	Shale	Lansing 3797
2815-2965	Shale and Lime	Base of Kansas City 4058
2965-3048	Lime and Shale	Fort Scott 4156
3048-3205	Shale	Cherokee Shale 4211
3205-3360	Lime	Cherokee Sand Zone 4273
3360-3580	Lime and Shale	Pennsylvanian Conglomerate 4363
3580-3712	Shale and Lime	Arbuckle 4404
3712-3833	Lime and Shale	Granite Wash 4490
3833-3905	Lime	Granite 4508
3905-3980	Lime and Shale	Welex Total Depth 4509
3980-4171	Shale and Lime	
4171-4207	Lime	
4207-4270	Shale and Lime	
4270-4334	Shale, Sand & Lime	
4334-4387	Shale, Lime & Chert	
4387-4405	Chert & Lime	
4405-4490	Arbuckle Lime & Shale	
4490-4505	Granite Wash and Granite	
4505	Driller's Total Depth	

I hereby certify that the above is a true and correct log of the above-captioned well as taken directly from the daily drilling reports.

GRAYBOL OIL CORPORATION

RECEIVED  
STATE CORPORATION COMMISSION

JUL 1 1963

7-1-63  
CONSERVATION DIVISION  
Wichita, Kansas

STATE OF OKLAHOMA

COUNTY OF TULSA

By: Lyman C. Dennis  
Lyman C. Dennis, Geologist

Subscribed and sworn to this 28th day of June, 1963.

My commission expires: October 8, 1966

Jan Carigan  
NOTARY PUBLIC