


STATE OF KANSAS  
STATE CORPORATION COMMISSION

WELL PLUGGING RECORD

Give All Information Completely  
Make Required Affidavit  
Mail or Deliver Report to  
Conservation Division  
State Corporation Comm.  
245 North Water  
Wichita, KS 67202

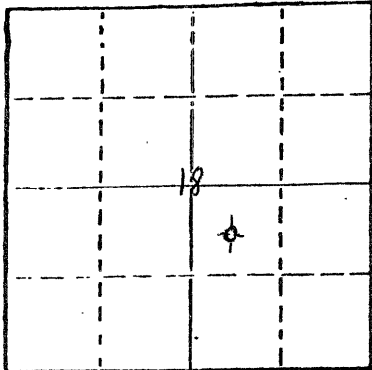

Locate well correctly on above  
Section Plot

Rawlins County. Sec. 18 Twp. 2 Rge. 33 E/W  
Location as "NE/CNW $\frac{1}{4}$ SW $\frac{1}{4}$ " or footage from lines

C-NW-SF  
Lease Owner Edward J. Ackman  
Lease Name Rosie Reuber Well No. 1  
Office Address 811 Denver Center Bldg.  
Character of Well (Completed as Oil, Gas or Dry Hole)

Dry Hole  
Date Well completed Sept. 10, 1977  
Application for plugging filed Oct. 30, 1977  
Application for plugging approved 1977  
Plugging commenced Sept. 10, 1977  
Plugging completed Sept. 10, 1977  
Reason for abandonment of well or producing formation

Dry Hole  
If a producing well is abandoned, date of last production  
None 1977  
Was permission obtained from the Conservation Division or  
its agents before plugging was commenced? yes

Name of Conservation Agent who supervised plugging of this well Leo Massey  
Producing formation none Depth to top Bottom Total Depth of Well 4323  
Show depth and thickness of all water, oil and gas formations.

OIL, GAS OR WATER RECORDS

CASING RECORD

| FORMATION | CONTENT | FROM | TO   | SIZE   | PUT IN | PULLED OUT |
|-----------|---------|------|------|--------|--------|------------|
| Surface   |         | 0    | 240' | 8 5/8" | 240'   | None       |
|           |         |      |      |        |        |            |
|           |         |      |      |        |        |            |
|           |         |      |      |        |        |            |

Describe in detail the manner in which the well was plugged, indicating where the mud fluid was placed and the method or methods used in introducing it into the hold. If cement or other plugs were used, state the character of same and depth placed, from feet to feet for each plug set.

70 sacks at 1200' Pumped by Halliburton  
20 sacks at 240' Pumped by Halliburton  
10 sacks at 40' Pumped by Halliburton

Rest of hole was filled with drilling mud

RECEIVED  
STATE CORPORATION COMMISSION

NOV 03 1977

11-3-77

CONSERVATION DIVISION  
Wichita, Kansas

(If additional description is necessary, use BACK of this sheet)

Name of Plugging Contractor Halliburton services

STATE OF COUNTY OF, ss.  
(employee of owner) or (owner or operator)  
of the above-described well, being first duly sworn on oath, says: That I have knowledge of the facts, statements, and matters herein contained and the log of the above-described well as filed and that the same are true and correct. So help me God.

(Signature) (Edward J. Ackman)  
811 Denver Center Bldg.  
(Address)

SUBSCRIBED AND SWORN TO before me this 31st day of October, 1977

My commission expires August 14, 1979

Notary Public.