


15-153-20218-00-00

STATE OF KANSAS
STATE CORPORATION COMMISSION
CONSERVATION DIVISION
P. O. BOX 17027
WICHITA, KANSAS 67217

FORM CP-4

WELL PLUGGING RECORD

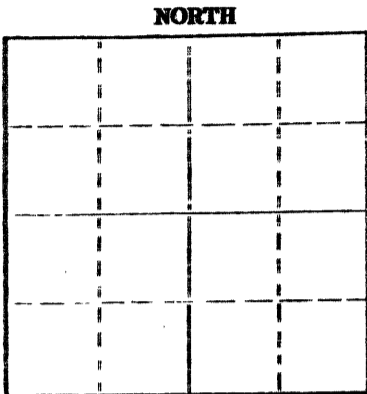

Locate well correctly on above Section Plat

Rawlins County. Sec. 6 Twp. 2 Rge. 33W (E) (W)
Location as "NE/CNW/SW" or footage from lines C NW NE
Lease Owner Pickrell Drilling Company
Lease Name Prochazka "A" Well No. 1
Office Address 705 4th Nat'l Bank Bldg. Wichita, Ks. 67202
Character of Well (completed as Oil, Gas or Dry Hole) Dry Hole
Date well completed 8-24 19 75
Application for plugging filed 8-24 19 75
Application for plugging approved 8-24 19 75
Plugging commenced 8-24 19 75
Plugging completed 8-24 19 75
Reason for abandonment of well or producing formation Dry Hole

If a producing well is abandoned, date of last production 19
Was permission obtained from the Conservation Division or its agents before plugging was commenced? Yes

Name of Conservation Agent who supervised plugging of this well Gilbert Balthazor
Producing formation _____ Depth to top _____ Bottom _____ Total Depth of Well 4290 Feet
Show depth and thickness of all water, oil and gas formations.

OIL, GAS OR WATER RECORDS

CASING RECORD

FORMATION	CONTENT	FROM	TO	SIZE	PUT IN	PULLED OUT
		209		8 5/8	209	None

Describe in detail the manner in which the well was plugged, indicating where the mud fluid was placed and the method or methods used in introducing it into the hole. If cement or other plugs were used, state the character of same and depth placed, from _____ feet to _____ feet for each plug set.

RECEIVED
STATE CORPORATION COMMISSION

OCT 2 1975

CONSERVATION DIVISION
Wichita, Kansas

20 sacks at 200'
10 sacks at 40'
Job comp. 8:30PM 8-24-75

(If additional description is necessary, use BACK of this sheet)

Name of Plugging Contractor PICKRELL DRILLING COMPANY
Address 705 4th Nat'l Bank Bldg. Wichita, Ks. 67202

STATE OF Kansas COUNTY OF Sedgwick ss.
C. W. Sebitts (employee of owner) or (owner or operator) of the above-described well, being first duly sworn on oath, says: That I have knowledge of the facts, statements and matters herein contained and the log of the above-described well as filed and that the same are true and correct. So help me God.

(Signature) C. W. Sebitts
705 4th Nat'l Bank Bldg. Wichita, Ks. 67202
(Address)

SUBSCRIBED AND SWORN TO before me this 18 day of Sept. 19 75

My commission expires
STATE NOTARY PUBLIC
HELEN L. MARTIN
Sedgwick County, Ks.
My Appmt. Exp. Aug. 19, 1979
KANSAS

Helen L. Martin
Notary Public.

ROTARY DRILLING LOG

15-153-20218-00-00

COMPANY: PICKRELL DRILLING COMPANY
705 4th Nat'l Bank Bldg.
Wichita, Ks. 67202

Rotary Drilling Commenced 8-15-75

Rotary Drilling Completed 8-24-75

LOCATION: Prochazka "A" #1
C NW NE 6-2S-33W
Rawlins Co., Ks.

CONTRACTOR: PICKRELL DRILLING COMPANY
Wichita, Kansas

CASING RECORD: 8 5/8" surface pipe set at 209' with 150 sacks cement. Job comp.
8-16-75 12:30 AM

LOG

(Figures indicate bottom of formation — measurements from top of rotary bushing.)

Top Soil & Sand	220
Shale	1220
Shale	2040
Shale	2400
Shale & Lime	2725
Shale & Lime	2885
Shale	2925
Shale	3280
Shale & Lime	3545
Lime & Shale	3550
Lime & Shale	3760
Lime	3820
Lime & Shale	3880
Lime & Shale	3930
Lime & Shale	3990
Lime & Shale	4035
Lime	4070
Lime	4083
Lime & Shale	4140
Lime & Shale	4160
Lime & Shale	4180
Shale & Lime	4205
Lime	4210
Lime	4280
Lime	4290

RECEIVED
STATE CORPORATION COMMISSION

OCT 2 1975
10-2-75
CONSERVATION DIVISION
Wichita, Kansas

The undersigned, C. W. Sebitts, Attorney-in-Fact for PICKRELL DRILLING COMPANY, hereby certifies in behalf of said Company, that the above is a true and correct log of the formation encountered in drilling the above well as reflected by the Daily Drilling Reports.

PICKRELL DRILLING COMPANY

By [Signature]
C. W. Sebitts, Attorney-in-Fact

STATE OF KANSAS }
COUNTY OF SEDGWICK } ss.:

On this 18 day of Sept., 19 75, before me the undersigned, Notary Public, in and for the County and State aforesaid, personally appeared C. W. Sebitts, to me known to be the identical person who subscribed the name of PICKRELL DRILLING COMPANY to the foregoing instrument as its Attorney-in-Fact and acknowledged to me that he executed the same as his free and voluntary act and deed, and as the free and voluntary act and deed of such company, for the uses and purposes therein set forth.

Given under my hand and seal of office the day and year last above written.

My commission expires:



[Signature]
Notary Public
Helen L. Martin