

For KCC Use: 8.22.04
Effective Date: 8.22.04
District #: 3
SGA? Yes No

KANSAS CORPORATION COMMISSION
OIL & GAS CONSERVATION DIVISION

First
CORRECTED

Form C-1
December 2002
Form must be Typed
Form must be Signed
All blanks must be Filled

NOTICE OF INTENT TO DRILL

Must be approved by KCC five (5) days prior to commencing well

Expected Spud Date August 23, 2004
month day year 8/23/04

Spot NE NE NE Sec. 26 Twp. 21 S. R. 13 East West

OPERATOR: License# 8210
Name: Edward E. Birk

500 feet from N / S Line of Section
350 390' feet from E / W Line of Section

Address: 302 South 16th
City/State/Zip: Burlington, Ks 66839

RECEIVED

Contact Person: Edward E. Birk
Phone: 620-364-2745

AUG 17 2004

CONTRACTOR: License# 33217
Name: Three Rivers Exploration, LLC

KCC WICHITA

Well Drilled For: Oil Enh Rec Gas Storage OWWO Seismic; # of Holes Other
Well Class: Infield Pool Ext. Wildcat Other
Type Equipment: Mud Rotary Air Rotary Cable

is SECTION Regular Irregular?
(Note: Locate well on the Section Plat on reverse side)

County: Coffey
Lease Name: Jamison Well #: 3

Field Name: Hatch
Is this a Prorated / Spaced Field? Yes No

Target Formation(s): Viola-Simpson, Cherokee Sands, and coals

Nearest Lease or unit boundary: 300 390' feet MSL

Ground Surface Elevation: n/a

Water well within one-quarter mile: Yes No

Public water supply well within one mile: Yes No

Depth to bottom of fresh water: 100+

Depth to bottom of usable water: 200+

Surface Pipe by Alternate: 1 2

Length of Surface Pipe Planned to be set: 40' min.

Length of Conductor Pipe required: none

Projected Total Depth: 2300'

Formation at Total Depth: Arbuckle

Water Source for Drilling Operations: Well Farm Pond Other

DWR Permit #: _____

(Note: Apply for Permit with DWR)

Will Cores be taken? Yes No

If Yes, proposed zone: _____

If OWWO: old well information as follows:

Operator: _____

Well Name: _____

Original Completion Date: _____ Original Total Depth: _____

Directional, Deviated or Horizontal wellbore? Yes No

If Yes, true vertical depth: _____

Bottom Hole Location: _____

KCC DKT #: _____

RECEIVED
KANSAS CORPORATION COMMISSION

AUG 19 2004

AFFIDAVIT

The undersigned hereby affirms that the drilling, completion and eventual plugging of this well will comply with K.S.A. 55 et. seq.

It is agreed that the following minimum requirements will be met:

1. Notify the appropriate district office prior to spudding of well;
2. A copy of the approved notice of intent to drill shall be posted on each drilling rig;
3. The minimum amount of surface pipe as specified below shall be set by circulating cement to the top; in all cases surface pipe shall be set through all unconsolidated materials plus a minimum of 20 feet into the underlying formation.
4. If the well is dry hole, an agreement between the operator and the district office on plug length and placement is necessary prior to plugging;
5. The appropriate district office will be notified before well is either plugged or production casing is cemented in;
6. If an ALTERNATE II COMPLETION, production pipe shall be cemented from below any usable water to surface within 120 days of spud date. Or pursuant to Appendix "B" - Eastern Kansas surface casing order #133,891-C, which applies to the KCC District 3 area, alternate II cementing must be completed within 30 days of the spud date or the well shall be plugged. In all cases, NOTIFY district office prior to any cementing.

I hereby certify that the statements made herein are true and to the best of my knowledge and belief.

Date: 8/16/04 Signature of Operator or Agent: Edward E. Birk Title: Owner

For KCC Use ONLY
API # 15 - 031-22028-00-00
Conductor pipe required NONE feet
Minimum surface pipe required 40 feet per AIL
Approved by: RJPB 8.17.04 / RJPB 8.23.04
This authorization expires: 2.17.05
(This authorization void if drilling not started within 6 months of effective date.)
Spud date: _____ Agent: _____

Remember to:

- File Drill Pit Application (form CDP-1) with Intent to Drill;
- File Completion Form ACO-1 within 120 days of spud date;
- File acreage attribution plat according to field proration orders;
- Notify appropriate district office 48 hours prior to workover or re-entry;
- Submit plugging report (CP-4) after plugging is completed;
- Obtain written approval before disposing or injecting salt water.
- If this permit has expired (See: authorized expiration date) please check the box below and return to the address below.

Well Not Drilled - Permit Expired

Signature of Operator or Agent: _____

Date: _____

Mail to: KCC - Conservation Division, 130 S. Market - Room 2078, Wichita, Kansas 67202

* WAS: 350' FEL, 350' FNLL
IS: 390' FEL, 390' FNLL

26
21
18E

RECEIVED
KANSAS CORPORATION COMMISSION

AUG 19 2004

CONSERVATION DIVISION
WICHITA, KS

IN ALL CASES PLOT THE INTENDED WELL ON THE PLAT BELOW

Plat of acreage attributable to a well in a prorated or spaced field

If the intended well is in a prorated or spaced field, please fully complete this side of the form. If the intended well is in a prorated or spaced field complete the plat below showing that the well will be properly located in relationship to other wells producing from the common source of supply. Please show all the wells and within 1 mile of the boundaries of the proposed acreage attribution unit for gas wells and within 1/2 mile of the boundaries of the proposed acreage attribution unit for oil wells.

API No. 15 - _____
Operator: Edward E. Birk
Lease: Jamison
Well Number: 3
Field: Hatch

Location of Well: County: Coffey
500 feet from N / S Line of Section
~~350~~ 390' * feet from E / W Line of Section
Sec. 26 Twp. 21 S. R. 13 East West

Number of Acres attributable to well: _____
QTR / QTR / QTR of acreage: NE - NE - NE


Is Section: Regular or Irregular

If Section is Irregular, locate well from nearest corner boundary.
Section corner used: NE NW SE SW


PLAT

*(Show location of the well and shade attributable acreage for prorated or spaced wells.)
(Show footage to the nearest lease or unit boundary line.)*

CORRECTED

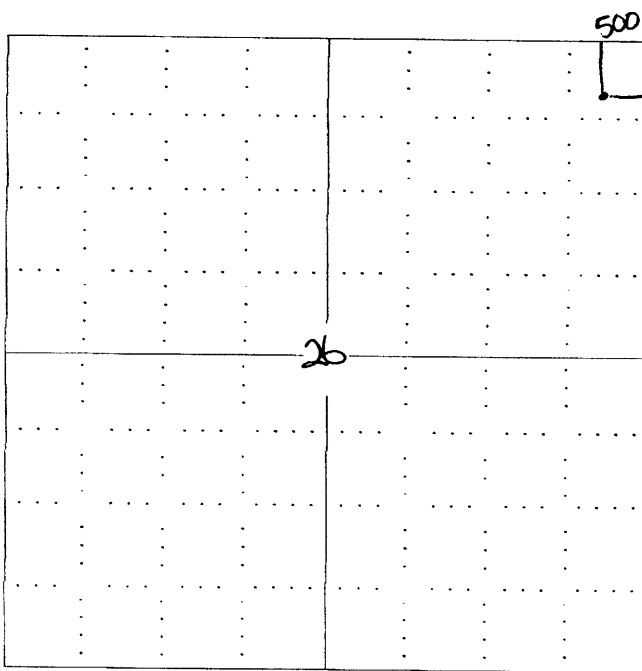

RECEIVED
AUG 17 2004
KCC WICHITA

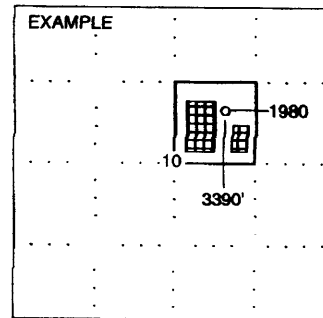

NOTE: In all cases locate the spot of the proposed drilling location.

In plotting the proposed location of the well, you must show:

1. The manner in which you are using the depicted plat by identifying section lines, i.e. 1 section, 1 section with 8 surrounding sections, 4 sections, etc.
2. The distance of the proposed drilling location from the section's south / north and east / west.
3. The distance to the nearest lease or unit boundary line.
4. If proposed location is located within a prorated or spaced field a certificate of acreage attribution plat must be attached: (CO-7 for oil wells; CG-8 for gas wells).