

OWWO

KANSAS CORPORATION COMMISSION  
OIL & GAS CONSERVATION DIVISION

Form C-1  
December 2002  
Form must be Typed  
Form must be Signed  
All blanks must be Filled

For KCC Use: 8-23-04  
Effective Date: \_\_\_\_\_  
District # 1  
SGA?  Yes  No

Must be approved by the K.C.C. five (5) days prior to commencing well

Expected Spud Date 8 23 04  
month day year

Spot \_\_\_\_\_  East  
SW - NE - NW Sec. 8 Twp. 17 S. R. 27  West  
\_\_\_\_\_ feet from  N /  S Line of Section  
\_\_\_\_\_ feet from  E /  W Line of Section

OPERATOR: License # 3842  
Name: LARSON OPERATING COMPANY  
A DIVISION OF LARSON ENGINEERING, INC.  
Address: 562 WEST HIGHWAY 4  
City/State/Zip: OLMITZ, KS 67564-8561  
Contact Person: TOM LARSON  
Phone: (620) 653-7368

RECEIVED

AUG 19 2004

KCC WICHITA

CONTRACTOR: License # 32592  
Name: WILD WEST WELL SERVICE, INC.

Well Drilled For:  Oil  Gas  OWWO  Seismic; # of Holes \_\_\_\_\_  
 Enh Rec  Storage  Disposal  Other \_\_\_\_\_  
Well Class:  Infield  Pool Ext.  Wildcat  Other \_\_\_\_\_  
Type Equipment:  Mud Rotary  Air Rotary  Cable

If OWWO: old well information as follows:  
Operator: PATTON OIL COMPANY  
Well Name: JOHNSON #1  
Original Completion Date: 3-1-83 Original Total Depth: 4597

Directional, Deviated or Horizontal wellbore?  Yes  No  
If yes, true vertical depth: \_\_\_\_\_  
Bottom Hole Location: \_\_\_\_\_  
KCC DKT#: \_\_\_\_\_

Is SECTION X Regular \_\_\_\_\_ Irregular?  
(Note: Locate well on the Section Plat on Reverse Side)  
County: LANE  
Lease Name: JOHNSON Well #: 1  
Field Name: PENDENNIS SW  
Is this a Prorated / Spaced Field?  Yes  No  
Target Formation(s): L-KC, MARMATON  
Nearest Lease or unit boundary: 990'  
Ground Surface Elevation: 2683 feet MSL  
Water well within one-quarter mile:  Yes  No  
Public water supply well within one mile:  Yes  No  
Depth to bottom of fresh water: 200  
Depth to bottom of usable water: 1300  
Surface Pipe by Alternate:  1  2 Alt 2 RSP/KCC  
Length of Surface Pipe Planned to be set: 402' SET BY ORIGINAL OPERATOR  
Length of Conductor pipe required: NONE  
Projected Total Depth: 4597' OTD  
Formation at Total Depth: MISSISSIPPI  
Water Source for Drilling Operations:  Well  Farm Pond Other WATER HAULER  
DWR Permit #: \_\_\_\_\_  
(Note: Apply for Permit with DWR )  
Will Cores Be Taken?  Yes  No  
If yes, proposed zone: \_\_\_\_\_

AFFIDAVIT

The undersigned hereby affirms that the drilling, completion and eventual plugging of this well will comply with K.S.A. 55-101, et. seq.  
It is agreed that the following minimum requirements will be met:

1. Notify the appropriate district office **prior** to spudding of well;
2. A copy of the approved Notice of Intent to Drill **shall be** posted on each drilling rig;
3. The minimum amount of surface pipe as specified below **shall be set** by circulating cement to the top; in all cases surface pipe **shall be set** through all unconsolidated materials plus a minimum of 20 feet into the underlying formation;
4. If the well is a dry hole, an agreement between the operator and the district office on plug length and placement is necessary **prior to plugging**;
5. The appropriate district office will be notified before well is either plugged or production casing is cemented in;
6. If an ALTERNATE II COMPLETION, production pipe shall be cemented from below any usable water to surface within **120 days** of spud date.  
Or pursuant to Appendix "B" - Eastern Kansas surface casing order #133,891-C, which applies to the KCC District 3 area, alternate II cementing must be completed within 30 days of spud date or the well shall be plugged. **In all cases, NOTIFY district office** prior to any cementing.

I hereby certify that the statements made herein are true and to the best of my knowledge and belief.

Date: 08/17/2004 Signature of Operator or Agent: Thomas Larson Title: PRESIDENT

Remember to:

- File Drill Pit Application (Form CDP-1) with Intent to Drill;
- File Completion Form ACO-1 within 120 days of spud date;
- File acreage attribution plat according to field proration orders;
- Notify appropriate district office 48 hours prior to workover or re-entry;
- Submit plugging report (CP-4) after plugging is completed;
- Obtain written approval before disposing or injecting salt water.
- If this permit has expired (See: authorized expiration date) please check the box below and return to the address below.

Well Not Drilled - Permit Expired

Signature of Operator or Agent: \_\_\_\_\_  
Date: \_\_\_\_\_

8  
17  
27

For KCC use ONLY  
API # 15 - 101 20754.00.01  
Conductor pipe required NONE feet  
Minimum surface pipe required 402 feet per Alt. # 2  
Approved by: RJP 8-23-04  
This authorization expires: 2-23-04  
(This authorization void if drilling not started within 6 months of effective date.)  
Spud date: \_\_\_\_\_ Agent: \_\_\_\_\_

Mail to: KCC - Conservation Division 130 S. Market - Room 2078, Wichita, Kansas 67202

**IN ALL CASES PLOT THE INTENDED WELL ON THE PLAT BELOW**

*Plat of Acreage attributable to a well in a prorated or spaced field*

**If the intended well is in a prorated or spaced field, please fully complete this side of the form.** If the intended well is in a prorated or spaced field complete the plat below showing that the well will be properly located in relationship to other wells producing from the common source of supply. Please show all the wells and within 1 mile of the boundaries of the proposed acreage attribution unit for gas wells and within 1/2 mile of the boundaries of the proposed acreage attribution unit for oil wells.

API No. 15 - 101-20754-0001  
LARSON OPERATING COMPANY  
Operator: A DIVISION OF LARSON ENGINEERING, INC.  
Lease: JOHNSON  
Well Number: 1  
Field: PENDENNIS SW

Location of Well: County: LANE  
990 feet from  N /  S Line of Section  
1650 feet from  E /  W Line of Section  
Sec. 8 Twp. 17 S. R. 27  East  West

Is Section:  Regular or  Irregular


Number of Acres attributable to well: 10  
QTR / QTR / QTR of acreage: \_\_\_\_\_ - \_\_\_\_\_ - NW/4

**If Section is Irregular, locate well from nearest corner boundary.**  
Section corner used:  NE  NW  SE  SW


**PLAT**

*(Show location of the well and shade attributable acreage for prorated or spaced wells.)*

*(Show footage to the nearest lease or unit boundary line.)*

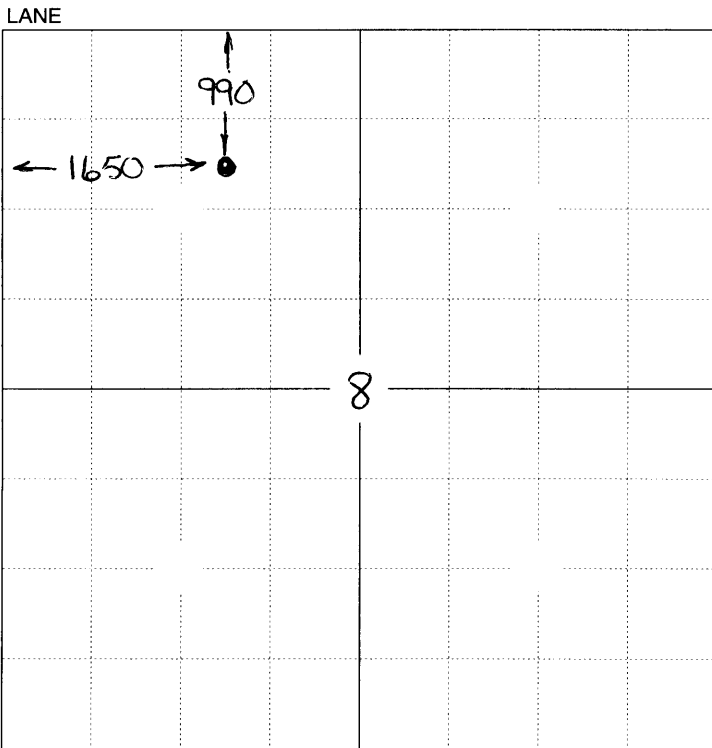

RECEIVED  
AUG 19 2004  
KCC WICHITA

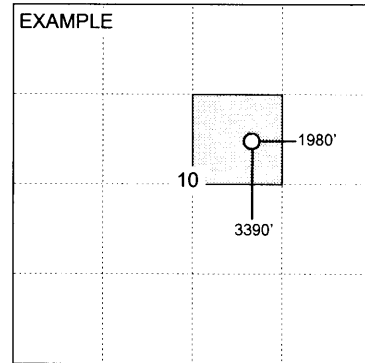

SEWARD CO.

**NOTE: In all cases locate the spot of the proposed drilling location.**

**In plotting the proposed location of the well, you must show:**

1. The manner in which you are using the depicted plat by identifying section lines, i.e. 1 section, 1 section with 8 surrounding sections, 4 sections, etc.
2. The distance of the proposed drilling location from the section's south / north and east / west.
3. The distance to the nearest lease or unit boundary line.
4. If proposed location is located within a prorated or spaced field a certificate of acreage attribution plat must be attached: (CO-7 for oil wells; CG-8 for gas wells).