

CARD MUST BE TYPED

State of Kansas

CARD MUST BE SIGNED

NOTICE OF INTENTION TO DRILL

(see rules on reverse side)

Starting Date 8-29-86 month day year 10:18

API Number 15- 153-20,665-00-00

OPERATOR: License # 5422

SE SE SW Sec. 12 Twp. 2 S, Rg 35 East X West

Name Abercrombie Drilling, Inc.

330' Ft. from South Line of Section

Address 801 Union Center

2970' Ft. from East Line of Section

City/State/Zip Wichita, KS 67202

(Note: Locate well on Section Plat on reverse side)

Contact Person Jack L. Partridge

Nearest lease or unit boundary line 330' feet

Phone (316) 262-1841

County Rawlins County, KS

CONTRACTOR: License # 5422

Lease Name Reeh Well # 1

Name Abercrombie Drilling, INC.

Ground surface elevation 3175' GL feet MSL

City/State Wichita, Kansas 67202

Domestic well within 330 feet: yes X no

Well Drilled For: Well Class: Type Equipment:

Municipal well within one mile: yes X no

X Oil SWD Infield X Mud Rotary

Depth to bottom of fresh water 200'

Gas Inj Pool Ext Air Rotary

Depth to bottom of usable water Ogallala 270'

OWWO Expl Wildcat Cable

Surface pipe by Alternate: X

If OWWO: old well info as follows:

Surface pipe planned to be set 275'

Operator

Conductor pipe required N/A

Well Name N/A

Projected Total Depth 4350' feet

Comp Date Old Total Depth

Formation Lansing/Kansas City

I certify that well will comply with K.S.A. 55-101, et seq., plus eventually plugging hole to KCC specifications.

Date Signature of Operator or Agent

Signature Title: Pres. President

For KCC Use:

Conductor Pipe Required 275 feet; Minimum Surface Pipe Required feet per Alt. 1 1/2

This Authorization Expires 3-1-87 Approved By 8-29-86


Handwritten signature: RCH/KCC

Must be filed with the K.C.C. five (5) days prior to commencing well  
 This card void if drilling not started within six (6) months of date received by K.C.C.

**Important procedures to follow:**

1. Notify District office before setting surface casing.
2. Set surface casing by circulating cement to the top.
3. File completion forms ACO-1 with K.C.C. within 90 days of well completion, following instructions on ACO-1, side 1, and including copies of wireline logs.
4. Notify District office 48 hours prior to old well workover or re-entry.
5. Prior to filing Intent, prepare a proposed plugging plan in case well is D & A, then obtain approval of plan when calling district office prior to setting surface pipe.
6. Submit plugging report (CP-4) to K.C.C. after plugging is completed.
7. Obtain an approved injection docket number before disposing of salt water.
8. Notify K.C.C. within 10 days when injection commences or terminates.
9. If an alternate 2 completion, cement in the production pipe from below any usable water to surface within 120 days of spud date.

**A Regular Section of Land**  
**1 Mile = 5,280 Ft.**

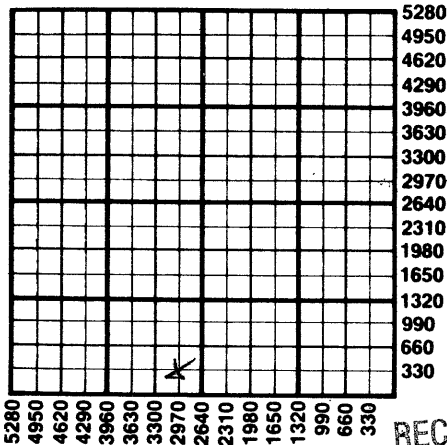

RECEIVED  
 STATE CORPORATION COMMISSION

AUG 29 1986  
 8-29-86  
 CONSERVATION DIVISION  
 Wichita, Kansas

State Corporation Commission of Kansas  
 Conservation Division  
 200 Colorado Derby Building  
 Wichita, Kansas 67202  
 (316) 263-3238