


15-023-30031-00-00

WELL PLUGGING RECORD

Give All Information Completely
Make Required Affidavit
Mail or Deliver Report to:
Conservation Division
State Corporation Commission
211 No. Broadway
Wichita, Kansas

Cheyenne County. Sec. 34 Twp. 2S Rge. (E) 40 (W)
Location as "NE/CNW%SW%" or footage from lines SW SW
Lease Owner Arvel C. Smith & Toto Gas Company
Lease Name Zweygardt Well No. 1
Office Address 534 N. Tallyrand, Wichita 6, Kansas
Character of Well (completed as Oil, Gas or Dry Hole) Dry Hole
Date well completed March 4, 1963
Application for plugging filed " " " " 19 " "
Application for plugging approved " " " " 19 " "
Plugging commenced " " " " 19 " "
Plugging completed " " " " 19 " "
Reason for abandonment of well or producing formation Dry Hole

NORTH

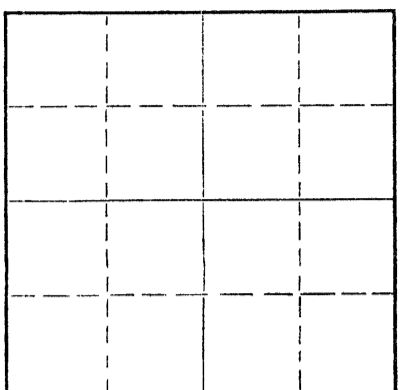

Locate well correctly on above
Section Plat

If a producing well is abandoned, date of last production _____ 19____
Was permission obtained from the Conservation Division or its agents before plugging was commenced? Yes

Name of Conservation Agent who supervised plugging of this well W. L. Nichols
Producing formation _____ Depth to top _____ Bottom _____ Total Depth of Well 5158 Feet
Show depth and thickness of all water, oil and gas formations.

OIL, GAS OR WATER RECORDS

CASING RECORD

FORMATION	CONTENT	FROM	TO	SIZE	PUT IN	PULLED OUT
	Surface Pipe	0	280'	8 5/8"		No

Describe in detail the manner in which the well was plugged, indicating where the mud fluid was placed and the method or methods used in introducing it into the hole. If cement or other plugs were used, state the character of same and depth placed, from _____ feet to _____ feet for each plug set.

0' - 30' Ten Sack Cement Plug
30' - 230' Heavy Mud
230' - 290' Twenty Sack Cement Plug
290' - T.D. Heavy Mud

RECEIVED
STATE CORPORATION COMMISSION

MAR 6 1963

3-6-63

CONSERVATION DIVISION
Wichita, Kansas

(If additional description is necessary, use BACK of this sheet)

Name of Plugging Contractor Natural Gas Drilling, Inc.
Address Box 1615, Oklahoma City, Oklahoma

STATE OF Kansas, COUNTY OF Sedgwick, ss.
Arvel C. Smith (employee of owner) or (owner or operator) of the above-described well, being first duly sworn on oath, says: That I have knowledge of the facts, statements, and matters herein contained and the log of the above-described well as filed and that the same are true and correct. So help me God.

(Signature) Arvel C. Smith
534 N. Tallyrand, Wichita 6, Kansas
(Address)

SUBSCRIBED AND SWORN TO before me this 5th day of March, 1963

Lenita T. Moore
Notary Public.

My commission expires June 30, 1966



INVOICED

DATE 3/6/63
INV. NO. 6683-w