


15-023-30025-06-00

STATE OF KANSAS  
STATE CORPORATION COMMISSION

Give All Information Completely  
Make Required Affidavit  
Mail or Deliver Report to:  
Conservation Division  
State Corporation Commission  
211 No. Broadway  
Wichita, Kansas

WELL PLUGGING RECORD

Cheyenne County, Sec. 6 Twp. 2 Rge. (E) 38 (W)  
Location as "NE/CNW/SW" or footage from lines SE SW  
Lease Owner National Associated Petroleum Co.  
Lease Name Gorthy etal "A" Well No. 1  
Office Address 502 Ritz Bldg. Tulsa, Okla.  
Character of Well (completed as Oil, Gas or Dry Hole) Dry hole  
Date well completed 2-6 19 60  
Application for plugging filed 11-19 19 62  
Application for plugging approved 2-26 19 60  
Plugging commenced 2-6 19 60  
Plugging completed 2-6 19 60  
Reason for abandonment of well or producing formation dry

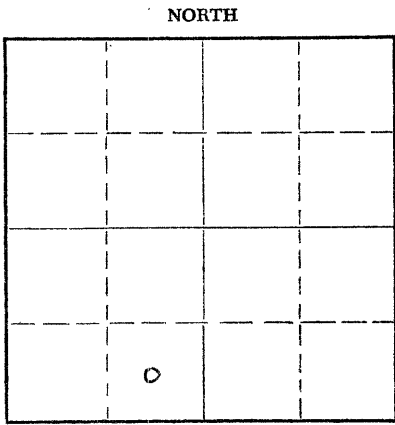

Locate well correctly on above  
Section Plat

If a producing well is abandoned, date of last production - 19 -  
Was permission obtained from the Conservation Division or its agents before plugging was commenced? yes

Name of Conservation Agent who supervised plugging of this well Mr. Fabricius  
Producing formation none Depth to top \_\_\_\_\_ Bottom \_\_\_\_\_ Total Depth of Well 5060 Feet  
Show depth and thickness of all water, oil and gas formations.

OIL, GAS OR WATER RECORDS

CASING RECORD

FORMATION	CONTENT	FROM	TO	SIZE	PUT IN	PULLED OUT
				8 5/8"	331'	none

Describe in detail the manner in which the well was plugged, indicating where the mud fluid was placed and the method or methods used in introducing it into the hole. If cement or other plugs were used, state the character of same and placed placed, from \_\_\_\_\_ feet to \_\_\_\_\_ feet for each plug set.

Filled hole with heavy mud to 500'; set plug and 20 sacks cement through drill pipe, heavy mud to 300'; set plug and 20 sacks cement, mud to 40'; set Plug and 10 sacks cement to surface.

**RECEIVED**  
STATE CORPORATION COMMISSION  
NOV 20 1962  
CONSERVATION DIVISION  
Wichita, Kansas

11-20-62

(If additional description is necessary, use BACK of this sheet)  
Name of Plugging Contractor Badger Drillers, Inc.  
Address Mayo Bldg., Tulsa, Oklahoma

STATE OF OKLAHOMA, COUNTY OF TULSA, ss.  
David A. Brierley (employee of ~~owner~~) or (owner or operator) of the above-described well, being first duly sworn on oath, says: That I have knowledge of the facts, statements, and matters herein contained and the log of the above-described well as filed and that the same are true and correct. So help me God.

(Signature) David A. Brierley  
David A. Brierley  
Ritz Building, Tulsa, Oklahoma  
(Address)

SUBSCRIBED AND SWORN to before me this 19th day of November, 19 62

My commission expires February 21, 1965  
Maxine D. Provine Notary Public.

