


STATE OF KANSAS
STATE CORPORATION COMMISSION

WELL PLUGGING RECORD

Give All Information Completely
Make Required Affidavit
Mail or Deliver Report to
Conservation Division
State Corporation Comm.
245 North Water
Wichita, KS 67202

Cheyenne County. Sec. 16 Twp. 2 Rge. 39 XX/W
Location as "NE/CNW $\frac{1}{4}$ SW $\frac{1}{4}$ " or footage from lines _____
1980' FNL & 1980' FWL of Section
Lease Owner BEARD OIL COMPANY
Lease Name Lewis-Federal Well No. 1-16
Office Address 2000 Classen Bldg Suite 200 So. OKC, OK, 73106
Character of Well (Completed as Oil, Gas or Dry Hole) _____

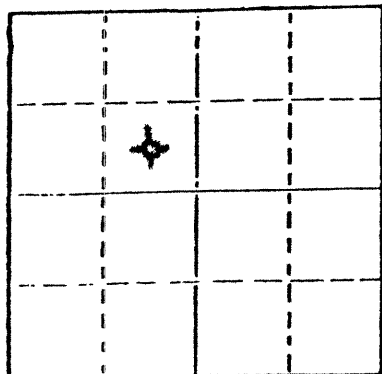

Locate well correctly on above
Section Plat

Dry Hole
Date Well completed February 1 1979
Application for plugging filed January 31 1979
Application for plugging approved January 31 (verbal) 1979
Plugging commenced February 1 1979
Plugging completed February 1 1979
Reason for abandonment of well or producing formation _____
Niobrara carried water
If a producing well is abandoned, date of last production _____
19 _____

Was permission obtained from the Conservation Division or
its agents before plugging was commenced? Yes
name not available - approval
secured by drilling contractor

Name of Conservation Agent who supervised plugging of this well _____
Producing formation None Depth to top None Bottom _____ Total Depth of Well 1400'
Show depth and thickness of all water, oil and gas formations.

OIL, GAS OR WATER RECORDS

CASING RECORD

FORMATION	CONTENT	FROM	TO	SIZE	PUT IN	PULLED OUT
Niobrara	water.	1195'	1350'	8-5/8"	173'	0

Describe in detail the manner in which the well was plugged, indicating where the mud fluid
was placed and the method or methods used in introducing it into the hold. If cement or other
plugs were used, state the character of same and depth placed, from see below feet to
 feet for each plug set.

- 50 sk cement plug from 1300 to 1150'
- 35 sk cement plug from 115 to 215'
- 10 sk cement plug from 0 to 40'
- 5 sk cement plug in rat hole

RECEIVED
STATE CORPORATION COMMISSION

FEB - 7 1979

CONSERVATION DIVISION
Wichita, Kansas

2-7-79

(If additional description is necessary, use BACK of this sheet)

Name of Plugging Contractor Sun Cementing Company Oberlin, Kansas

STATE OF Oklahoma COUNTY OF Oklahoma, ss.
James W. Vater, Jr. (employee of owner) or (owner or operator)
of the above-described well, being first duly sworn on oath, says: That I have knowledge of
the facts, statements, and matters herein contained and the log of the above-described well
as filed and that the same are true and correct. So help me God.

(Signature) James W. Vater

2000 Classen Bldg Suite 200 So. OKC, OK, 73106
(Address)

SUBSCRIBED AND SWORN TO before me this 5th day of February, 1979

Thomasine L. Garrett
Notary Public.

My commission expires 11-5-82