

15-023-20005-00-00


STATE OF KANSAS
STATE CORPORATION COMMISSION

Form CP-4

Give All Information Completely
Make Required Affidavit
Mail or Deliver Report to:
Conservation Division
State Corporation Commission
212 No. Market
Wichita, Kansas

WELL PLUGGING RECORD

NORTH

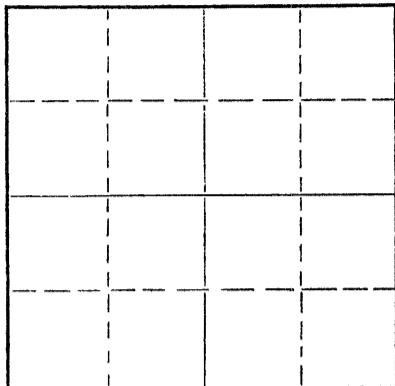

Locate well correctly on above
Section Plat

Cheyenne County. Sec. 8 Twp. 2S Rge. 37W (X) (W) West
Location as "NE/CNW $\frac{1}{2}$ SW $\frac{1}{4}$ " or footage from lines. Approx. S $\frac{1}{2}$ SE SE
Lease Owner MACK OIL CO.
Lease Name Wilkens Well No. 1
Office Address 812 Union Center Bldg., Wichita, Kansas 67202
Character of Well (completed as Oil, Gas or Dry Hole) Dry Hole
Date well completed November 4 1968
Application for plugging filed November 4 1968
Application for plugging approved November 4 1968
Plugging commenced November 5 1968
Plugging completed November 5 1968
Reason for abandonment of well or producing formation Dry

If a producing well is abandoned, date of last production _____ 19____
Was permission obtained from the Conservation Division or its agents before plugging was commenced? Yes

Name of Conservation Agent who supervised plugging of this well W. L. Nichols, Moreland, Kansas
Producing formation None Depth to top _____ Bottom _____ Total Depth of Well 5035 Feet
Show depth and thickness of all water, oil and gas formations.

OIL, GAS OR WATER RECORDS

CASING RECORD

FORMATION	CONTENT	FROM	TO	SIZE	PUT IN	PULLED OUT

Describe in detail the manner in which the well was plugged, indicating where the mud fluid was placed and the method or methods used in introducing it into the hole. If cement or other plugs were used, state the character of same and depth placed, from _____ feet to _____ feet for each plug set.

Plugged with 120 sacks common cement @ 2500'
20 sacks common cement @ 360'
10 sacks common cement @ 40'
Plug down @ 1:00 p.m., November 5, 1968

RECEIVED
STATE CORPORATION COMMISSION
NOV 8 1968
CONSERVATION DIVISION
Wichita, Kansas

11-8-68

(If additional description is necessary, use BACK of this sheet)
Name of Plugging Contractor MACK OIL CO.
Address P. O. Box 400, Duncan, Oklahoma 73533

STATE OF KANSAS, COUNTY OF SEDGWICK, ss.
Robert L. Harris (employee of owner) or (owner or operator) of the above-described well, being first duly sworn on oath, says: That I have knowledge of the facts statements, and matters herein contained and the log of the above-described well as filed and that the same are true and correct. So help me God.

(Signature) Robert L. Harris
812 Union Center Bldg., Wichita, Kansas
(Address)

SUBSCRIBED AND SWORN to before me this 7th day of November, 19 68

My commission expires September 21, 1972

Elizabeth F. Nice
Notary Public.