

STATE OF KANSAS
KANSAS CORPORATION COMMISSION
CONSERVATION DIVISION
130 South Market - Room 2078
Wichita, Kansas 67202

FORM CP-1 (3/92)

WELL PLUGGING APPLICATION FORM
(PLEASE TYPE FORM and File ONE Copy)

API # 15-129-21010-00-0P (Identifier number of this well). This must be listed for wells drilled since 1967; if no API# was issued, indicate spud or completion date.

WELL OPERATOR BEREXCO, INC. KCC LICENSE # 5363
(owner/company name) (operator's)

ADDRESS P.O. Box 20380 CITY Wichita

STATE Kansas ZIP CODE 67208-1380 CONTACT PHONE # (316) 265-3311

LEASE Brothers WELL# 3 SEC. 3 T. 31S R. 41W (East/West)

NE SPOT LOCATION/QQQQ COUNTY Morton

4620 FEET (in exact footage) FROM S/N (circle one) LINE OF SECTION (NOT Lease Line)

1980 FEET (in exact footage) FROM E/W (circle one) LINE OF SECTION (NOT Lease Line)

Check One: OIL WELL GAS WELL D&A SWD/ENHR WELL DOCKET#

CONDUCTOR CASING SIZE SET AT CEMENTED WITH SACKS

SURFACE CASING SIZE 8-5/8" SET AT 1577' CEMENTED WITH 615 SACKS

PRODUCTION CASING SIZE 5-1/2" SET AT 5672' CEMENTED WITH 875' SACKS

LIST (ALL) PERFORATIONS and BRIDGEPLUG SETS: Perfs: 5409-18 Bridge Plug@4980'

ELEVATION 3388 3400 T.D. 5800' PBTD 4980' ANHYDRITE DEPTH 1570
(G.L./K.B.) (Stone Corral Formation)

CONDITION OF WELL: GOOD POOR CASING LEAK JUNK IN HOLE

PROPOSED METHOD OF PLUGGING ACCORDING TO THE RULES AND REGULATIONS OF THE STATE
OF KANSAS.

RECEIVED
MAR 03 2003
KCC WICHITA

(If additional space is needed attach separate page)

IS WELL LOG ATTACHED TO THIS APPLICATION AS REQUIRED? No IS ACO-1 FILED?

If not explain why? Unavailable

PLUGGING OF THIS WELL WILL BE DONE IN ACCORDANCE WITH K.S.A. 55-101 et. seq. AND THE RULES AND REGULATIONS OF THE STATE CORPORATION COMMISSION.

LIST NAME OF COMPANY REPRESENTATIVE AUTHORIZED TO BE IN CHARGE OF PLUGGING OPERATIONS:

Evan Mayhew PHONE# (316) 772-8650

ADDRESS P.O. Box 20380 City/State Wichita, Kansas 67208-1380

PLUGGING CONTRACTOR Mike's Testing & Salvage Inc. KCC LICENSE # 31529
(company name) (contractor's)

ADDRESS P.O. Box 467 Chase, Kansas 67524 PHONE # () (316) 938-2943

PROPOSED DATE AND HOUR OF PLUGGING (if known?) ASAP 4-10-03 Plugged


PAYMENT OF THE PLUGGING FEE (K.A.R. 82-3-118) WILL BE GUARANTEED BY OPERATOR OR AGENT

DATE: 2-28-03 AUTHORIZED OPERATOR/AGENT: Mike Galvin
(signature)

WELL NAME + No
LOCATION

BEREKCO INC OP. No 5363
BROTHERS #3 API# 15-129-21010
CANNON SEC 3-315-41W
MORTON Co KS KB-3400 GL-3388

BEREKCO CONTACTS - CALL PRIOR TO RIG UP
FOREMAN - GREG KLAUS CEL-316-772-8650
SUBLETTE KS
ENGINEER - EVAN MAYHEW 316-265-3311
WICHITA

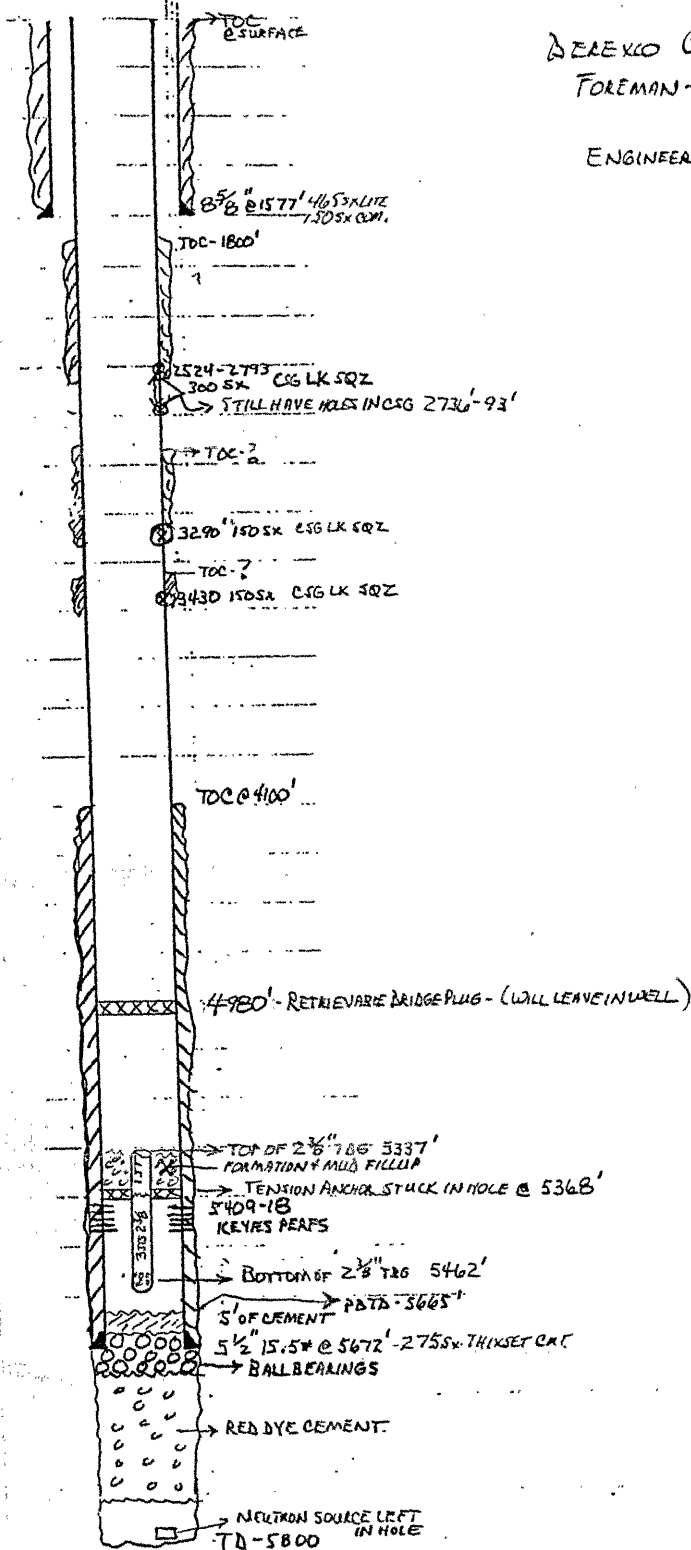

RECEIVED
MAR 03 2003
KCC WICHITA