

This form shall be filed in duplicate with the Kansas Corporation Commission, 200 Colorado Derby Building, Wichita, Kansas 67202, within ten days after the completion of the well, regardless of how the well was completed.

Attach separate letter of request if the information is to be held confidential. If confidential, only file one copy. Information on side one will be of public record and side two will then be held confidential.

Circle one: (Oil) Gas, Dry, SWD, OWWO, Injection. Type and complete ALL sections. Applications must be filed for dual completion, commingling, SWD and injection.

Attach wireline logs (i.e. electrical log, sonic log, gamma ray neutron log, etc.). KCC # (316) 263-3238. (Rules 82-2-105 & 82-2-125)

OPERATOR Trans-Western Petroleum, Inc.

API NO. 15-153-20,433 00-00

ADDRESS 704-1651 California

COUNTY Rawlins

Denver, Colorado 80202

FIELD Wildcat B. Ramm E

**CONTACT PERSON John Karpenko

PROD. FORMATION Marm, Oread

PHONE (303)825-1625

LEASE Wilkens

PURCHASER Ashland Oil

WELL NO. 1-17

ADDRESS 1401 Winchester Avenue

WELL LOCATION SE SW NE

Ashland, Kentucky

100 Ft. from East Line and

DRILLING Stoepelwerth Drilling, Inc.

500 Ft. from South Line of

CONTRACTOR

ADDRESS 1111 H Street

the NE/4 SEC. 17 TWP. 2S RGE. 36W

McCook, Nebraska

RECEIVED STATE CORPORATION COMMISSION 12-21-81 DEPT. OF REVENUE


PLUGGING

CONTRACTOR

ADDRESS

CONSERVATION DIVISION Wichita Kansas

WELL PLAT

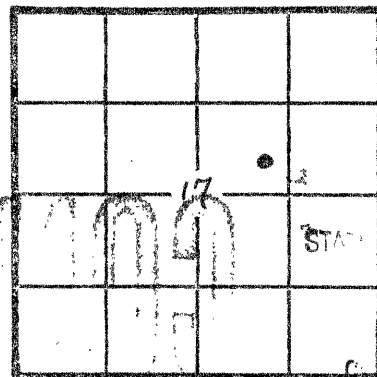

KCC KGS (Office Use)

TOTAL DEPTH 4821' PBD 4791'

SPUD DATE 10-4-81 DATE COMPLETED 12-9-81

ELEV: GR 3362' DF KB 3367

DRILLED WITH (CABLE) (ROTARY) (AIR) TOOLS

Amount of surface pipe set and cemented 510' DV Tool Used? No

AFFIDAVIT

STATE OF Colorado, COUNTY OF Denver SS, I, John

Karpenko OF LAWFUL AGE, BEING FIRST DULY SWORN UPON HIS OATH,

DEPOSES THAT HE IS Geologist (FOR)(OF) Trans-Western Petroleum, Inc.

OPERATOR OF THE Wilkens LEASE, AND IS DULY AUTHORIZED TO MAKE

THIS AFFIDAVIT FOR AND ON THE BEHALF OF SAID OPERATOR, THAT WELL NO. 1-17 ON

SAID LEASE HAS BEEN COMPLETED AS OF THE 9th DAY OF December, 1981, AND THAT

ALL INFORMATION ENTERED HEREIN WITH RESPECT TO SAID WELL IS TRUE AND CORRECT.

FURTHER AFFIANT SAITH NOT.

SUBSCRIBED AND SWORN BEFORE ME THIS 17th DAY OF December, 1981.

(S) John Karpenko

Andrew A. Orea

NOTARY PUBLIC

MY COMMISSION EXPIRES: 061685

**The person who can be reached by phone regarding any questions concerning this information. Within 45 days of completion, a witnessed initial test by the Commission is required if the well produces more than 25 BOPD or is located in a Basic Order Pool.