

CARD MUST BE TYPED

State of Kansas
NOTICE OF INTENTION TO DRILL
(see rules on reverse side)

CARD MUST BE SIGNED

Starting Date: 6 15 85
month day year 3:55

API Number 15- 023-20, 23500-00

OPERATOR: License # 6593
Name Coastal Oil & Gas Corporation
Address Box 749
City/State/Zip Denver, CO 80202
Contact Person Lee Thying
Phone (303) 573-4459

..... C.S.W S.E Sec. 30 Twp. 24S, Rge. 37. East
(location) West

..... 6.60... Ft North from Southeast Corner of Section
..... 198.0.... Ft West from Southeast Corner of Section
(Note: Locate well on Section Plat on reverse side)

CONTRACTOR: License # 6033
Name Murfin Drilling Co.
City/State 250 N. Water, Wichita, KS

Nearest lease or unit boundary line 6.60 feet.
County Cheyenne

Lease Name Panbacker Well# 1-30

Domestic well within 330 feet : yes no

Municipal well within one mile : yes no

Well Drilled For: **Well Class:** **Type Equipment:**
 Oil Swd Infield Mud Rotary
 Gas Inj Pool Ext. Air Rotary
 OWWO Expl Wildcat Cable

Depth to Bottom of fresh water 27.5 feet

Lowest usable water formation

Depth to Bottom of usable water 330 feet

Surface pipe by Alternate : 1 2

Surface pipe to be set 400 feet

Conductor pipe if any required

Ground surface elevation

This Authorization Expires 12-12-85

Approved By 6-12-85 [Signature]

If OWWO: old well info as follows:

Operator
Well Name
Comp Date Old Total Depth
Projected Total Depth 5400 feet
Projected Formation at TD Pre-Cambrian

I certify that we will comply with K.S.A. 55-101, et seq., plus eventually plugging hole to K.C.C. specifications.

Date ... 6/12/85 ... Signature of Operator or Agent [Signature] Title

MHC/KOHE 6-12-85

As. Agent


RECEIVED
 STATE CORPORATION COMMISSION

Must be filed with the K.C.C. five (5) days prior to commencing well
 This receipt is void if drilling not started within six (6) months of date received by K.C.C.

JUN 12 1985
 6-12-85

CONSERVATION DIVISION

Wichita, Kansas
A Regular Section of Land
1 Mile = 5,280 Ft.

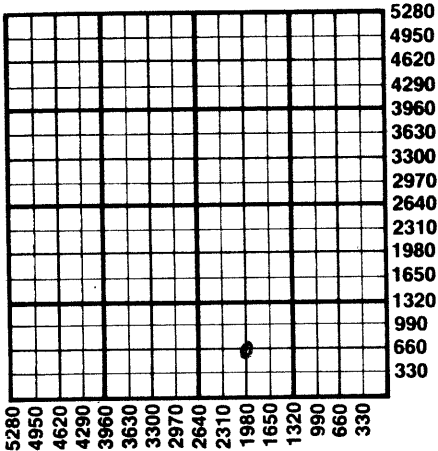

Important procedures to follow:

1. Notify District office before setting surface casing.
2. Set surface casing by circulating cement to the top.
3. File completion forms ACO-1 with K.C.C. within 90 days of well completion, following instructions on ACO-1, side 1, and including copies of wireline logs.
4. Notify District office 48 hours prior to old well workover or re-entry.
5. Prior to plugging, prepare a plugging plan, then obtain agreement from the appropriate district office for an approved plugging plan.
6. Submit plugging report (CP-4) to K.C.C. after plugging is completed.
7. Obtain an approved injection docket number before disposing of salt water.
8. Notify K.C.C. within 10 days when injection commences or terminates.
9. If an alternate 2 completion, cement in the production pipe from below any usable water to surface within 120 days of spud date.

State Corporation Commission of Kansas
 Conservation Division
 200 Colorado Derby Building
 Wichita, Kansas 67202
 (316) 263-3238