

CARD MUST BE TYPED

State of Kansas

NOTICE OF INTENTION TO DRILL

(see rules on reverse side)

CARD MUST BE SIGNED

Extended to 12-11-86
6-6-86

Starting Date 12 - 14 - 85
month day year

API Number 15- 023-20,243-00-00

OPERATOR: License # 4528

SE SW NW Sec. 21 Twp. 2 S, Rg. 37 East
2970 West
4290

Name Paul Prijatel

Address 201 W. 8th St. Suite 450

City/State/Zip Pueblo, Colorado 81003

Contact Person Paul Prijatel

Phone (303) 544-2111 or 485-3646

Ft. from South Line of Section

Ft. from East Line of Section

(Note: Locate well on Section Plat on reverse side)

CONTRACTOR: License # 8682

Name Golden Eagle Drilling, Inc.

City/State McCook, Nebraska

Nearest lease or unit boundary line 330 feet

County Cheyenne

Lease Name Glasco Well # 21-5

Ground surface elevation 3380 feet MSL

Well Drilled For: Well Class: Type Equipment:

X Oil SWD Infield X Mud Rotary

Gas Inj Pool Ext Air Rotary

OWWO Expl Wildcat Cable

Domestic well within 330 feet: yes no

Municipal well within one mile: yes no

Surface pipe by Alternate: 1 x 2

Depth to bottom of fresh water 300

Depth to bottom of usable water 350

Surface pipe planned to be set 4900 350 ft

Projected Total Depth 4900 feet

Formation Cherokee

If OWWO: old well info as follows:

Operator

Well Name

Comp Date Old Total Depth

I certify that well will comply with K.S.A. 55-101, et seq., plus eventually plugging hole to KCC specifications.

cementing will be done immediately upon setting production casing.

Date 12-9-85 Signature of Operator or Agent Paul Prijatel Title Geologist

For KCC Use:

Conductor Pipe Required feet; Minimum Surface Pipe Required feet per Alt. 2


This Authorization Expires 6-11-86 Approved By 12-11-85

Must be filed with the K.C.C. five (5) days prior to commencing well
This card void if drilling not started within six (6) months of date received by K.C.C.

Important procedures to follow:

1. Notify District office before setting surface casing.
2. Set surface casing by circulating cement to the top.
3. File completion forms ACO-1 with K.C.C. within 90 days of well completion, following instructions on ACO-1, side 1, and including copies of wireline logs.
4. Notify District office 48 hours prior to old well workover or re-entry.
5. Prior to filing Intent, prepare a proposed plugging plan in case well is D & A, then obtain approval of plan when calling district office prior to setting surface pipe.
6. Submit plugging report (CP-4) to K.C.C. after plugging is completed.
7. Obtain an approved injection docket number before disposing of salt water.
8. Notify K.C.C. within 10 days when injection commences or terminates.
9. If an alternate 2 completion, cement in the production pipe from below any usable water to surface within 120 days of spud date.

**A Regular Section of Land
1 Mile = 5,280 Ft.**

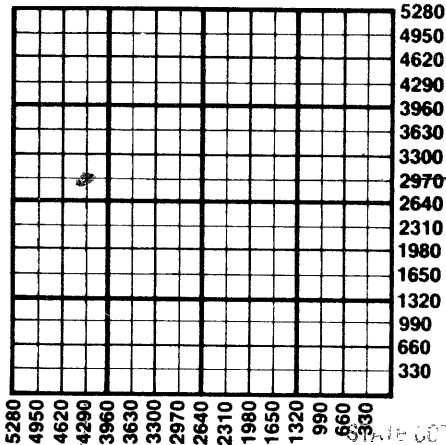

DEC 14 1985
12-11-85
CONSERVATION DIVISION
Wichita, Kansas

State Corporation Commission of Kansas
Conservation Division
200 Colorado Derby Building
Wichita, Kansas 67202
(316) 263-3238