


STATE OF KANSAS
STATE CORPORATION COMMISSION

15-153-20017-00-00 Form CP-4

WELL PLUGGING RECORD

Give All Information Completely
Make Required Affidavit
Mail or Deliver Report to:
Conservation Division
State Corporation Commission
212 No. Market
Wichita, Kansas

NORTH

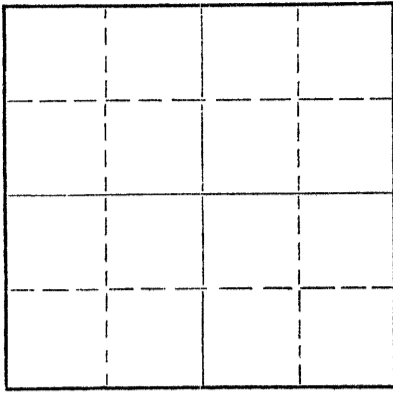

Locate well correctly on above
Section Plat

Rawlins County. Sec. 32 Twp. 2S Rge. 34W (E) (W)
Location as "NE/CNW/SW" or footage from lines NW NE NE
Lease Owner James M. Stewart
Lease Name Ankle Estate Well No. 1
Office Address 608 Union Center, Wichita, Kansas
Character of Well (completed as Oil, Gas or Dry Hole) Dry Hole
Date well completed 4-14-68 19
Application for plugging filed 4-14-68 19
Application for plugging approved 4-14-68 19
Plugging commenced 4-14-68 19
Plugging completed 4-14-68 19
Reason for abandonment of well or producing formation Dry Hole

If a producing well is abandoned, date of last production 19
Was permission obtained from the Conservation Division or its agents before plugging was commenced? yes

Name of Conservation Agent who supervised plugging of this well W. L. Nichols
Producing formation _____ Depth to top _____ Bottom _____ Total Depth of Well 4565 Feet
Show depth and thickness of all water, oil and gas formations.

OIL, GAS OR WATER RECORDS

CASING RECORD

FORMATION	CONTENT	FROM	TO	SIZE	PUT IN	PULLED OUT
				8 5/8"	248'	none

Describe in detail the manner in which the well was plugged, indicating where the mud fluid was placed and the method or methods used in introducing it into the hole. If cement or other plugs were used, state the character of same and depth placed, from _____ feet to _____ feet for each plug set.

Set Plug @ 1925' with 100 sacks Posmix with 6% gel
Set Plug @ 270' with 20 sks. Posmix, 6% gel
Bridged plug @ 40' with 1/2 sk. hulls, 10 sks. cement

RECEIVED
STATE CORPORATION COMMISSION
APR 18 1968
CONSERVATION DIVISION
Wichita, Kansas

(If additional description is necessary, use BACK of this sheet)

Name of Plugging Contractor Leben Drilling, Inc.
Address Box 486, Great Bend, Kansas 67530

STATE OF KANSAS, COUNTY OF BARTON, ss.
Leslie Kite

(employee of owner) or (owner or operator) of the above-described well, being first duly sworn on oath, says: That I have knowledge of the facts, statements, and matters herein contained and the log of the above-described well as filed and that the same are true and correct. So help me God.

(Signature) Leslie Kite

Box 486, Great Bend, Kansas 67530
(Address)

SUBSCRIBED AND SWORN TO before me this 17th day of April, 1968

My commission expires April 1, 1971

Ulanda Nichols
Notary Public.