

WELL PLUGGING RECORD

Give All Information Completely
Make Required Affidavit
Mail or Deliver Report to:
Conservation Division
State Corporation Commission
211 No. Broadway
Wichita, Kansas

Cheyenne

County. Sec. 4 Twp. 2S Rge. 42 (X) W (W)

Location as "NE/CNW/SW" or footage from lines 1000' FEL 1550' FSL

Lease Owner J-W Operating Company

Lease Name Isaac-Samler Unit Well No. 1

Office Address P. O. Box 305 - Wray, Colorado 80758

Character of Well (completed as Oil, Gas or Dry Hole) dry hole

Date well completed 12-16- 19 78

Application for plugging filed 12-16- 19 78

Application for plugging approved 12-16- (verbal) 19 78


Plugging commenced 6:00 PM, 12-16- 19 78

Plugging completed 8:00 PM, 12-16- 19 78

Reason for abandonment of well or producing formation dry hole

If a producing well is abandoned, date of last production ---- 19 --

Was permission obtained from the Conservation Division or its agents before plugging was commenced? Yes

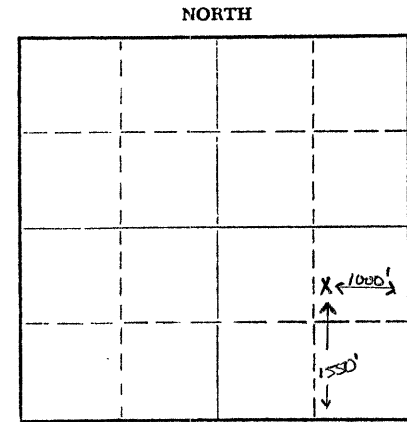

Locate well correctly on above Section Plat

Name of Conservation Agent who supervised plugging of this well Leo Massey

Producing formation _____ Depth to top _____ Bottom _____ Total Depth of Well 2190 Feet

Show depth and thickness of all water, oil and gas formations.

OIL, GAS OR WATER RECORDS

CASING RECORD

FORMATION	CONTENT	FROM	TO	SIZE	PUT IN	PULLED OUT
Smoky Hills chalk	water	1682'	1716'	7"	211'	None

Describe in detail the manner in which the well was plugged, indicating where the mud fluid was placed and the method or methods used in introducing it into the hole. If cement or other plugs were used, state the character of same and depth placed, from _____ feet to _____ feet for each plug set.

50 sx. cmt. from 2190' to 1930'

20 sx. cmt. from 211' to 111'

10 sx. cmt. from 50' to surface

RECEIVED
STATE CORPORATION COMMISSION

JAN 22 1979

1-22-79

CONSERVATION DIVISION
Wichita, Kansas

(If additional description is necessary, use BACK of this sheet)

Name of Plugging Contractor Cementer's Inc.

Address P. O. Box 412 - Scottsbluff, Nebraska 69361

STATE OF COLORADO, COUNTY OF YUMA, ss.

LOYD L. BROWN

(employee of owner) or (owner or operator) of the above-described well, being first duly sworn on oath, says: That I have knowledge of the facts, statements, and matters herein contained and the log of the above-described well as filed and that the same are true and correct. So help me God.

(Signature) [Signature]

P.O. BOX 305 WRAY, COLO.

(Address)

SUBSCRIBED AND SWORN TO before me this 19th day of JANUARY, 1979

[Signature]

My commission expires 8-1-82

Notary Public.