

CARD MUST BE TYPED

State of Kansas

CARD MUST BE SIGNED ✓

NOTICE OF INTENTION TO DRILL

(see rules on reverse side)

Expected Spud Date. July 15, 1987
month day year

API Number 15— 023-20,249-0000

OPERATOR: License # 5447
Name Cities Service Oil and Gas Corp.
Address 3545 NW 58th Street
City/State/Zip Oklahoma City, OK 73112
Contact Person Raymond Hui
Phone (405) 949-4268

W/2 SW/4 NE/4 26 Sec. 2 Twp. 2 S, Rg. 42 X West
3300 Ft. from South Line of Section
2310 Ft. from East Line of Section

(Note: Locate well on Section Plat on reverse side)

CONTRACTOR: License #
Name Unknown at this time
City/State

Nearest lease or unit boundary line 1980 feet
County Cheyenne
Lease Name Northrup A Well # 6

Well Drilled For: Well Class: Type Equipment:
 Oil Storage Infield Mud Rotary
 Gas Inj Pool Ext. Air Rotary
 OWWO Expl Wildcat Cable

Ground surface elevation est. 3695' feet MSL
Domestic well within 330 feet: yes no
Municipal well within one mile: yes no

If OWWO: old well info as follows:

Depth to bottom of fresh water 125'
Depth to bottom of usable water 550' 325'
Surface pipe by Alternate: 1 ~~2~~ ~~X~~

Operator
Well Name
Comp Date Old Total Depth

Surface pipe planned to be set 375'
Conductor pipe required None
Projected Total Depth 5400' feet

I certify that well will comply with K.S.A. 55-101, et seq., plus eventually plugging hole to KCC specifications.

Date 6/30/87 Signature of Operator or Agent Raymond Hui Raymond Hui Accounting Control Analyst

For KCC Use:

Conductor Pipe Required _____ feet; Minimum Surface Pipe Required 375 feet per Alt. 1 ~~X~~

This Authorization Expires 1-1-88 Approved By Ray 7-1-87

Must be filed with the K.C.C. five (5) days prior to commencing well
 This card void if drilling not started within six (6) months of date received by K.C.C.


Important procedures to follow:

1. Notify District office before setting surface casing.
2. Set surface casing by circulating cement to the top.
3. File completion forms ACO-1 with K.C.C. within 120 days of well spud date, following instructions on ACO-1, side 1, and including copies of wireline logs.
4. Notify District office 48 hours prior to old well workover or re-entry.
5. Prior to filing Intent, prepare a proposed plugging plan in case well is D & A, then obtain approval of plan when calling district office prior to setting surface pipe.
6. Submit plugging report (CP-4) to K.C.C. after plugging is completed.
7. Obtain an approved injection docket number before disposing of salt water.

Notify K.C.C. within 10 days when injection commences or terminates.

If an alternate 2 completion, cement in the production pipe from below any usable water to surface within 120 days of spud date.

A Regular Section of Land
 1 Mile = 5,280 Ft.

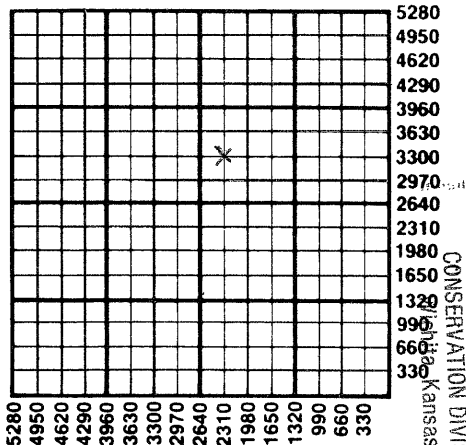

Conservation Division
 State Corporation Commission
 Wichita, Kansas

JUL 1 1987
 7-1-87

RECEIVED
 STATE CORPORATION COMMISSION

State Corporation Commission of Kansas
 Conservation Division
 200 Colorado Derby Building
 Wichita, Kansas 67202-1212
 (316) 263-3238