

EFFECTIVE DATE: 7-26-94
DISTRICT # 4
ESAT... Yes... No

State of Kansas
NOTICE OF INTENTION TO DRILL

MAIL TO EMPH.OIL
HOWWON
FORM MUST BE SIGNED
ALL BLANKS MUST BE FILLED

Must be approved by the K.C.C. five (5) days prior to commencing well

Expected Spud Date July 26, 1994 130' W S/2 S/2 NW. Sec 6... Twp 2... S. Rg 34... X East
month day year

OPERATOR: License # 9325 ✓
Name: Allied Oil Company, Inc.
Address: HC 3, Box 45A
City/State/Zip: Taneyville, MO 65759
Contact Person: ROY GRANT
Phone: (417)-546-5885

2970 feet from South North line of Section
4090 feet from East West line of Section
IS SECTION X REGULAR IRREGULAR?

CONTRACTOR: License #: 8241 ✓
Name: Emphasis Oil Operations

(NOTE: Locate well on the Section Plat on Reverse Side)
County: Rawlins
Lease Name: Frank Trust Well #: 1
Field Name: St. John Cemetery
Is this a Prorated/Spaced Field? ... yes X no ✓
Target Formation(s): Base Kansas City ✓
Nearest lease or unit boundary: 330' ✓
Ground Surface Elevation: 3181 feet MSL
Water well within one-quarter mile: ... yes X no
Public water supply well within one mile: ... yes X no
Depth to bottom of fresh water: 300'
Depth to bottom of usable water: 780'
Surface Pipe by Alternate: X 1 Prey ✓ Set
Length of Surface Pipe 302' set: 302' Prey ✓ Set
Length of Conductor pipe required: N/A
Projected Total Depth: 4450'
Formation at Total Depth: Lansing
Water Source for Drilling Operations: ✓
... well X farm pond other
DWR Permit #: _____
Will Cores Be Taken?: ... yes X no
If yes, proposed zone: _____

Well Drilled For: Well Class: Type Equipment:
X Oil ✓ ... Enh Rec ... Infield ..X Mud Rotary
X Gas ✓ ... Storage ... Pool Ext. ... Air Rotary
X OUVUO ✓ ... Disposal ... Wildcat ... Cable
... Seismic; ... # of Holes X Other
... Other

If OUVUO: old well information as follows:
Operator: Marmik Oil Company
Well Name: Frank Trust
Comp. Date: 3-30-92 Old Total Depth 4450'

Directional, Deviated or Horizontal wellbore? ... yes X no
If yes, true vertical depth: _____
Bottom Hole Location: _____

AFFIDAVIT

The undersigned hereby affirms that the drilling, completion and eventual plugging of this well will comply with K.S.A. 55-101, et. seq.
It is agreed that the following minimum requirements will be met:

1. Notify the appropriate district office prior to spudding of well;
2. A copy of the approved notice of intent to drill shall be posted on each drilling rig;
3. The minimum amount of surface pipe as specified below shall be set by circulating cement to the top; in all cases surface pipe shall be set through all unconsolidated materials plus a minimum of 20 feet into the underlying formation;
4. If the well is dry hole, an agreement between the operator and the district office on plug length and placement is necessary prior to plugging;
5. The appropriate district office will be notified before well is either plugged or production casing is cemented in;
6. IF AN ALTERNATE II COMPLETION, PRODUCTION PIPE SHALL BE CEMENTED FROM BELOW ANY USABLE WATER TO SURFACE WITHIN 120 DAYS OF SPUD DATE. IN ALL CASES, NOTIFY DISTRICT OFFICE PRIOR TO ANY CEMENTING.

I hereby certify that the statements made herein are true and to the best of my knowledge and belief.
Date: 7-19-94 Signature of Operator or Agent: _____ Title: Agent

FOR KCC USE:
API # 15- 153-20788-00-01 "40WUO"
Conductor pipe required 0 feet
Minimum surface pipe required 302 feet per Alt. 1 X
Approved by: CB 7-21-94
This authorization expires: 1-21-95
(This authorization void if drilling not started within 6 months of effective date.)
Spud date: _____ Agent: _____

REMEMBER TO:

- File Drill Pit Application (form CDP-1) with Intent to Drill;
- File Completion Form ACO-1 within 120 days of spud date;
- File acreage attribution plat according to field proration orders;
- Notify appropriate district office 48 hours prior to workover or re-entry;
- Submit plugging report (CP-4) after plugging is completed;
- Obtain written approval before disposing or injecting salt water.

Mail to: Conservation Division, 200 Colorado Derby Building, 202 W. First St., Wichita, Kansas 67202-1286.

RECEIVED
STATE CORPORATION COMMISSION
JUL 21 1994
CONSERVATION DIVISION
Wichita, Kansas
6
2
34

IN ALL CASES PLOT THE INTENDED WELL ON THE PLAT BELOW

PLAT OF ACREAGE ATTRIBUTABLE TO A WELL IN A PRORATED OR SPACED FIELD

If the intended well is in a prorated or spaced field, please fully complete this side of the form. If the intended well is in a prorated or spaced field complete the plat below showing that the well will be properly located in relationship to other wells producing from the common source of supply. Please show all the wells within 1 mile of the boundaries of the proposed acreage attribution unit for gas wells and within 1/2 mile of the boundaries of the proposed acreage attribution unit for oil wells.

API NO. 15- _____
OPERATOR _____
LEASE _____
WELL NUMBER _____
FIELD _____

LOCATION OF WELL: COUNTY _____
_____ feet from south/north line of section
_____ feet from east/west line of section
SECTION _____ TWP _____ RG _____



NUMBER OF ACRES ATTRIBUTABLE TO WELL _____
QTR/QTR/QTR OF ACREAGE _____

IS SECTION _____ REGULAR or _____ IRREGULAR
IF SECTION IS IRREGULAR, LOCATE WELL FROM NEAREST CORNER BOUNDARY.

Section corner used: _____ NE _____ NW _____ SE _____ SW

PLAT

(Show location of the well and shade attributable acreage for prorated or spaced wells.)
(Show footage to the nearest lease or unit boundary line.)

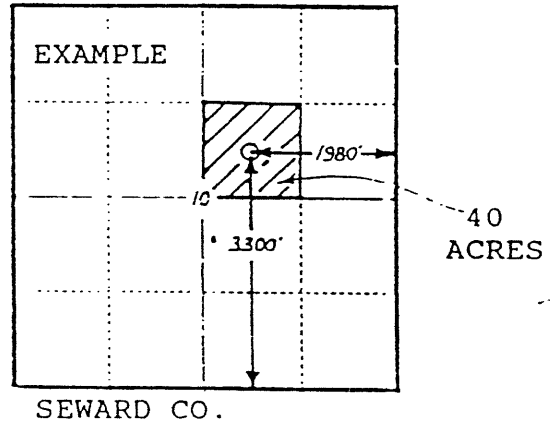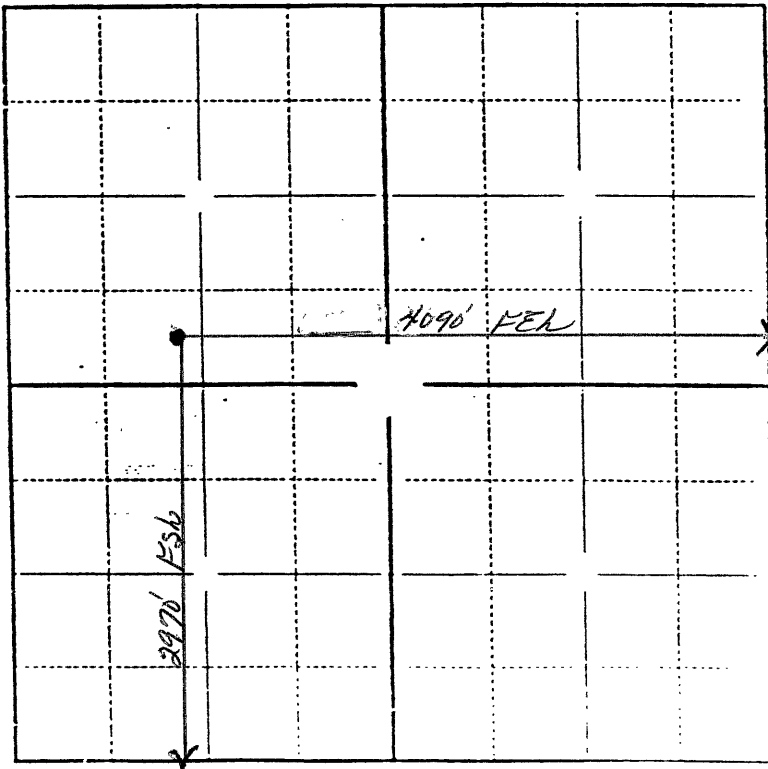

In plotting the proposed location of the well, you must show:

- 1) The manner in which you are using the depicted plat by identifying section lines, i.e. 1 section, 1 section with 8 surrounding sections, 4 sections, etc.;
- 2) the distance of the proposed drilling location from the section's south/north and east/west lines; and
- 3) the distance to the nearest lease or unit boundary line.