

WELL PLUGGING RECORD

Give All Information Completely  
Make Required Affidavit  
Mail or Deliver Report to:  
Conservation Division  
State Corporation Commission  
212 North Market, Insurance Bldg.  
Wichita, Kansas

CHEYENNE

County. Sec. 11 Twp 2s Rge. (E) 41 (W)

Location as "NE/CNW%SW%" or footage from lines Ctr NW of the NW

Lease Owner E. J. ATHENS

Lease Name RATH

Well No. 1

Office Address Philtower Building, Tulsa 3, Oklahoma

Character of Well (completed as Oil, Gas or Dry Hole) Dry

Date well completed November 10 1959

Application for plugging filed November 10 (Phone) 1959

Application for plugging approved November 11 (Phone) 1959


Plugging commenced November 11 1959

Plugging completed November 11 1959

Reason for abandonment of well or producing formation Dry Hole, No. commercial production

If a producing well is abandoned, date of last production ---- 19---

Was permission obtained from the Conservation Division or its agents before plugging was commenced? yes

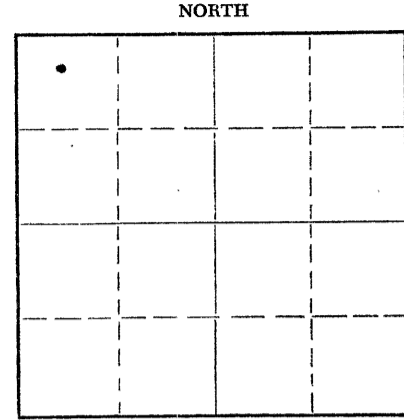

Locate well correctly on above Section Plat

Name of Conservation Agent who supervised plugging of this well A. D. Fabricus

Producing formation --- Depth to top --- Bottom --- Total Depth of Well 5280 Feet

Show depth and thickness of all water, oil and gas formations.

OIL, GAS OR WATER RECORDS

CASING RECORD

FORMATION	CONTENT	FROM	TO	SIZE	PUT IN	PULLED OUT
Sand	fresh water	180	210	8 5/8	255'	none

Describe in detail the manner in which the well was plugged, indicating where the mud fluid was placed and the method or methods used in introducing it into the hole. If cement or other plugs were used, state the character of same and depth placed, from \_\_\_\_\_ feet to \_\_\_\_\_ feet for each plug set.

Hole was filled to top with heavy mud and at the direction of the plugging agent pumped down 20 sacks of regular cement and spotted plug at 500' from surface, another 20 sacks plug at 250' and placed 10 sacks in the top of the surface pipe.

REC  
STATE CORP

JAN 6 1960

CONSERVATION DIVISION  
Wichita, Kansas

1-6-60

(If additional description is necessary, use BACK of this sheet)

Name of Plugging Contractor REED DRILLING COMPANY, INC.

Address 1209 Atlas Life Building, Tulsa 3, Oklahoma

STATE OF OKLAHOMA, COUNTY OF TULSA, ss.

R. B. Reed

(employee of owner) or (owner or operator) of the above-described

well, being first duly sworn on oath, says: That I have knowledge of the facts, statements, and matters herein contained and the log of the above-described well as filed and that the same are true and correct. So help me God.

(Signature) R. B. Reed R. B. Reed

1209 Atlas Bldg., Tulsa 3, Okla

(Address)

SUBSCRIBED AND SWORN TO before me this 5th day of January, 1960

Margaret E. Ginn

Notary Public.

My commission expires 12/10/62



R  
WELL LOG

15-023-00019-00-00

WELL: Rath #1 Spudding Date; 10-4-59  
 LOCATION: C NW NW 11-2S-41W Date Casing Set  
 Cheyenne County, Kansas Date Rotary Completed: 11-11-59

OWNER: E. J. Athens  
 Philtower Building  
 Tulsa 3, Oklahoma

FROM:	TO:	FORMATION:
0	1415	Shale
1415	1960	Shale & Shells
1960	2140	Shale
2140	2170	Lime
2170	2303	Shale
2303	3010	Snad & Shale
3010	3200	Shale & Shells
3200	3460	Shale, Sand, Anyhdrite
3460	3855	Shale & Shells
3855	5095	Lime & Shale
5095	5228	Shale & Sand
5228	5285	Lime
	5285	Total Depth

ELECTRIC LOG TOPS:

4296 Lansing  
 4716 Base 3 Kansas City  
 4913 Cherokee  
 5228 Mississippian

RECEIVED  
 STATE  
 FEB 12 1960  
 2-12-60  
 CONSERVATION DIVISION  
 Wichita, Kansas

I certify the above and foregoing to be a true and exact copy of the original driller's log on the Rath No. 1.

REED DRILLING COMPANY, INC.

BY R. B. Reed  
 president

Subscribed and sworn to before me this 9th day of February, 1960.

Margaret E. Grimes  
 Notary Public

My Commission Expires:  
 December 10, 1962

STATE OF KANSAS COMMISSION  
 FEB 11 1960  
 Secretary