

WELL PLUGGING RECORD

Give All Information Completely
Make Required Affidavit
Mail or Deliver Report to:
Conservation Division
State Corporation Commission
212 North Market, Insurance Bldg.
Wichita, Kansas

CHEYENNE County. Sec. 28 Twp. 2 SRge. (E) 41 (W)

Location as "NE/CNW%SW%" or footage from lines Ctr SW SW

Lease Owner E. J. Athens

Lease Name Zimbelman Well No. 1

Office Address 1209 Philtower Building, Tulsa 3, Oklahoma

Character of Well (completed as Oil, Gas or Dry Hole) Dry

Date well completed 12-8 1959

Application for plugging filed 12-8 (Phone) 1959

Application for plugging approved 12-8 (Phone) 1959


Plugging commenced 12-9 1959

Plugging completed 12-9 1959

Reason for abandonment of well or producing formation No commercial shows in well

If a producing well is abandoned, date of last production ----- 19---

Was permission obtained from the Conservation Division or its agents before plugging was commenced? yes

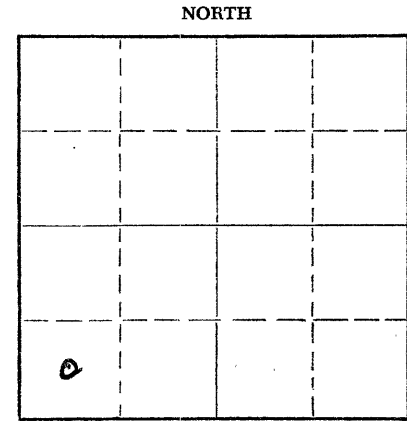

Locate well correctly on above Section Plat

Name of Conservation Agent who supervised plugging of this well A. D. Fabricus

Producing formation ----- Depth to top -- Bottom -- Total Depth of Well 5420 Feet

Show depth and thickness of all water, oil and gas formations.

OIL, GAS OR WATER RECORDS

CASING RECORD

FORMATION	CONTENT	FROM	TO	SIZE	PUT IN	PULLED OUT
Sand	Fresh Water	165	220	8 5/8	254'	None

Describe in detail the manner in which the well was plugged, indicating where the mud fluid was placed and the method or methods used in introducing it into the hole. If cement or other plugs were used, state the character of same and depth placed, from _____ feet to _____ feet for each plug set.

Hole was filled with heavy drilling mud and cement plugs were spotted at the direction of the plugging agent as follows:

20 Sacks regular cement at 500'

20 sacks regular cement at 300'

Surface hole was left open at the direction of the plugging agent for the landowner to make an irrigation well. Authorization for same signed by the land owner is attached hereto.

RECEIVED
STATE CORPORATION COMMISSION

JAN 6 1960

CONSERVATION DIVISION
Wichita, Kansas

1-6-60

(If additional description is necessary, use BACK of this sheet)

Name of Plugging Contractor REED DRILLING COMPANY, INC.

Address 1209 AtlasLife Building, Tulsa 3, Oklahoma

STATE OF OKLAHOMA, COUNTY OF TULSA, ss.

R. B. REED (employee of owner) or (owner or operator) of the above-described

well, being first duly sworn on oath, says: That I have knowledge of the facts, statements, and matters herein contained and the log of the above-described well as filed and that the same are true and correct. So help me God.

(Signature) R. B. Reed R. B. REED

1209 Atlas Life Bldg., Tulsa 3,
(Address)

SUBSCRIBED AND SWORN TO before me this 5th day of January, 1960

Margaret E. Gaines
Notary Public.

My commission expires December 10, 1962



R
Well Log

15-023-00024-00-00

WELL: Zimbelman #1 Spudding Date: 11-13-59
 LOCATION: C SW SW 28-2S41W Date Casing Set;
 Cheyenne County, Kansas Date Rotary Completed: 12-9-59

OWNER: E. J. Athens
 Philtower Building
 Tulsa 3, Oklahoma

FROM:	TO:	FORMATION:
0	1540	Shale
1540	2120	Shale & Shells
2120	2310	Shale
2310	2340	Lime
2340	2490	Shale
2490	2725	Sand
2725	2850	Shale & Sand
2850	2950	Sand
2950	3110	Sand & Shale
3110	3320	Shale & Shells
3320	#3600	Shale, Sand, Anhydrite
3600	4000	Shale & Shells
4000	5270	Lime & Shale
5270	5360	Shale
5360	5372	Sand
5372	5420	Lime
5420		

TOTAL DEPTH

ELECTRIC LOG TOPS:

4542	Lansing
4878	Base Kansas City
5068	Cherokee
5372	Mississippian

I Certify the above and foregoing to be a true and exact copy of the original driller's log on the Zimbelman #1.

REED DRILLING COMPANY, INC.

BY R. B. Reed
 PRESIDENT

Subscribed and sworn to before me this 9th day of February, 1960.

Margaret E. Grimes
 NOTARY PUBLIC

My Commission Expires:
December 10, 1962

