

15-023-20003-0000


STATE OF KANSAS
STATE CORPORATION COMMISSION

Form CP-4

Give All Information Completely
Make Required Affidavit
Mail or Deliver Report to:
Conservation Division
State Corporation Commission
212 No. Market
Wichita, Kansas

WELL PLUGGING RECORD

NORTH

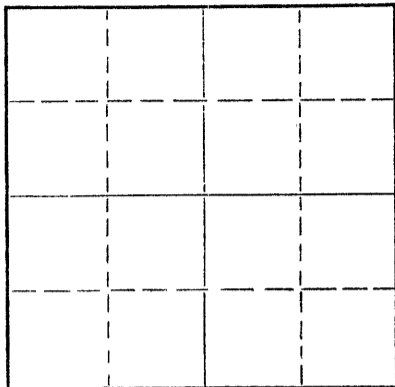

Locate well correctly on above
Section Plat

Cheyenne County. Sec. 25 Twp. 2S Rge. 41W (~~X~~) W (W)
Location as "NE/CNW/SW" or footage from lines C SE SE
Lease Owner MACK OIL CO.
Lease Name Raile Well No. 1
Office Address 812 Union Center Bldg., Wichita, Kansas
Character of Well (completed as Oil, Gas or Dry Hole) Dry Hole
Date well completed 10-2 19 68
Application for plugging filed 10-2 19 68
Application for plugging approved 10-2 19 68
Plugging commenced 10-2 19 68
Plugging completed 10-2 19 68
Reason for abandonment of well or producing formation Dry Hole

If a producing well is abandoned, date of last production _____ 19____
Was permission obtained from the Conservation Division or its agents before plugging was commenced? Yes

Name of Conservation Agent who supervised plugging of this well W. L. Nichols, Moreland, Kansas
Producing formation None Depth to top _____ Bottom _____ Total Depth of Well 5300 Feet
Show depth and thickness of all water, oil and gas formations.

OIL, GAS OR WATER RECORDS

CASING RECORD

FORMATION	CONTENT	FROM	TO	SIZE	PUT IN	PULLED OUT

Describe in detail the manner in which the well was plugged, indicating where the mud fluid was placed and the method or methods used in introducing it into the hole. If cement or other plugs were used, state the character of same and depth placed, from _____ feet to _____ feet for each plug set.

Filled hole with heavy mud.
Plug w/100 sx 2680' to 360'
Plug w/ 30 sx 360' to 40'
Plug w/ 10 sx 40' to top.
PD 4:00 p.m., 10-2-68.

RECEIVED
STATE CORPORATION COMMISSION
OCT 9 - 1968
CONSERVATION DIVISION
Wichita, Kansas 10-9-68

(If additional description is necessary, use BACK of this sheet)
Name of Plugging Contractor Mack Oil Co.
Address P.O. Box 400, Duncan, Oklahoma 73533

STATE OF Kansas, COUNTY OF Sedgwick, ss.
Robert L. Harris (employee of owner) or (owner or operator) of the above-described well, being first duly sworn on oath, says: That I have knowledge of the facts, statements, and matters herein contained and the log of the above-described well as filed and that the same are true and correct. So help me God.

(Signature) Robert L. Harris
812 Union Center Bldg, Wichita, Kansas
(Address)

Subscribed and Sworn to before me this 7th day of October, 1968
July 24, 1971
GINNY ALDEN
Notary Public.



MACK OIL COMPANY
Duncan, Oklahoma

DRILLERS WELL LOG

#1 Raile

C SE SE - Section 25-2S-41W
Cheyenne County, Kansas
Elevation: 3542' KB
Initial Production: Dry
Contractor: Mack Oil Company

Commenced R.D.: 9-16-68
Completed R.D.: 10- 2-68
Drillers Total Depth: 5300'

<u>STRATA</u>	<u>DEPTH</u>
Shale & Clay	0- 365
Shale	365-3120
Anhydrite	3120-3175
Shale & Shells	3175-3288
Anhydrite, Sand & Shale	3288-3446
Anhydrite & Shale	3446-3461
Red Beds, Shale & Shells	3461-3970
Shale & Lime	3970-4328
Lime	4328-4510
Lime & Shale	4510-4558
Lime	4558-4686
Sand & Lime	4686-4707
Lime	4707-5016
Lime & Shale	5016-5082
Lime	5082-5300

I hereby certify that the above is a true and correct log of said well as reflected by the daily drilling reports.

MACK OIL COMPANY

By Robert L. Harris
Robert L. Harris

Signed and sworn to in my presence this 7th day of October, 1968,
by Robert L. Harris, representative of Mack Oil Company.

Ginny Alden
Ginny Alden, Notary Public



My commission expires:
July 24, 1971

RECEIVED
STATE CORPORATION COMMISSION

OCT 9 - 1968

CONSERVATION DIVISION
Wichita, Kansas

10-9-68