

CARD MUST BE TYPED

State of Kansas
NOTICE OF INTENTION TO DRILL
(see rules on reverse side)

Collection
CARD MUST BE SIGNED
12-5-84

Starting Date: 12 - 1 84
month day year

API Number 15- 013-10,222-000

OPERATOR: License # KCC 9978

SWNW (location) Sec 9 Twp 2 S, Rge 41 East West

Name Hawthorne exploration co

Address P O Box 503

City/State/Zip Sun Valley Idaho 83353

Contact Person Don Adams

Phone (303) 292-4265

3480 Ft North from Southeast Corner of Section
4930 Ft West from Southeast Corner of Section
(Note: Locate well on Section Plat on reverse side)

CONTRACTOR: License # 6033 9187

Nearest lease or unit boundary line 350 feet.

County Cheyenne

Name ~~Marlin Drilling Co~~ Western Well Drilling Inc

Lease Name Hawthorne Schewel Well# 12-9

City/State ~~Wichita, Kansas~~ Healdsburg, Colo

Domestic well within 330 feet: yes no

Municipal well within one mile: yes no

Well Drilled For: Well Class: Type Equipment:

Oil Swd Infield Mud Rotary

Gas Inj Pool Ext. Air Rotary

OWWO Expl Wildcat Cable

Depth to Bottom of fresh water 300 150 mhc feet

Lowest usable water formation 300 Unconsolidated

Depth to Bottom of usable water 300 feet

Surface pipe by Alternate: 1 2

Surface pipe to be set 350 feet

Conductor pipe if any required NONE feet

Ground surface elevation 3600 feet MSL

This Authorization Expires 5-26-85

Approved By 11-26-84 R.C.

If OWWO: old well info as follows:

Operator

Well Name

Comp Date Old Total Depth

Projected Total Depth 1700 feet

Projected Formation at TD Niobrara

Expected Producing Formations

I certify that we will comply with K.S.A. 55-101, et seq., plus eventually plugging hole to K.C.C. specifications.

Date 11-18-84 Signature of Operator or Agent J.S.D. Adams


Title Agent

mhc/KCONE 11/26/84

Must be filed with the K.C.C. five (5) days prior to commencing well
This card void if drilling not started within six (6) months of date received by K.C.C.

Important procedures to follow :

**A Regular Section of Land
1 Mile = 5,280 Ft.**

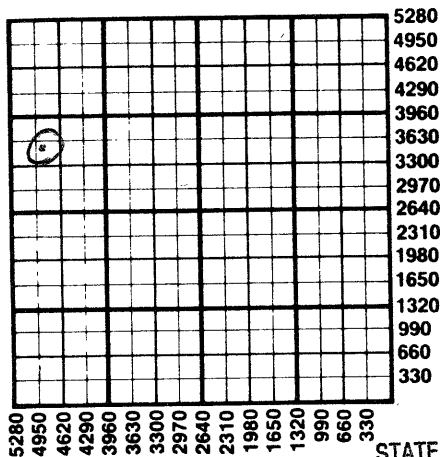

1. Notify District office before setting surface casing.
2. Set surface casing by circulating cement to the top.
3. File completion forms ACO-1 with K.C.C. within 90 days of well completion, following instructions on ACO-1, side 1, and including copies of wireline logs.
4. Notify District office 48 hours prior to old well workover or re-entry.
5. Prior to plugging, prepare a plugging plan, then obtain agreement from the appropriate district office for an approved plugging plan.
6. Submit plugging report (CP-4) to K.C.C. after plugging is completed.
7. Obtain an approved injection docket number before disposing of salt water.
8. Notify K.C.C. within 10 days when injection commences or terminates.
9. If an alternate 2 completion, cement in the production pipe from below any usable water to surface within 120 days of spud date.

RECEIVED

STATE CORPORATION COMMISSION State Corporation Commission of Kansas

11-26-84
NOV 26 1984

Conservation Division
200 Colorado Derby Building
Wichita, Kansas 67202
(316) 263-3238

CONSERVATION DIVISION
Wichita, Kansas -