


15-183-00008-00-00

WELL PLUGGING RECORD

Give All Information Completely
Make Required Affidavit
Mail or Deliver Report to:
Conservation Division
State Corporation Commission
211 No. Broadway
Wichita, Kansas

Smith County. Sec. 20 Twp. 3 Rge. 14 (E) W (W)
Location as "NE/CNW/SW" or footage from lines NW NW NW
Lease Owner Kim Oil Company
Lease Name Conway Well No. 1
Office Address Russell, Kansas
Character of Well (completed as Oil, Gas or Dry Hole) Dry Hole
Date well completed October 23 19 61
Application for plugging filed October 23 19 61
Application for plugging approved October 23 19 61
Plugging commenced October 23 19 61
Plugging completed October 23 19 61
Reason for abandonment of well or producing formation Dry Hole

NORTH

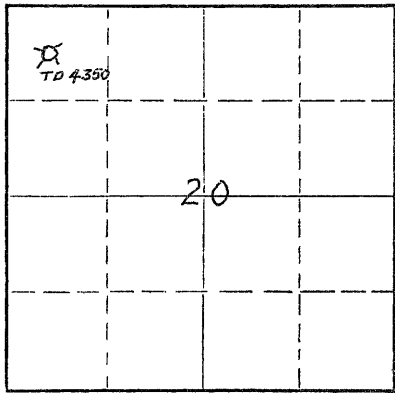

Locate well correctly on above Section Plat

If a producing well is abandoned, date of last production 19
Was permission obtained from the Conservation Division or its agents before plugging was commenced? Yes

Name of Conservation Agent who supervised plugging of this well Don Trun
Producing formation Depth to top Bottom Total Depth of Well 4350 Feet
Show depth and thickness of all water, oil and gas formations.

OIL, GAS OR WATER RECORDS

CASING RECORD

FORMATION	CONTENT	FROM	TO	SIZE	PUT IN	PULLED OUT
Surface Pipe		0	150	8 5/8	150'	0

Describe in detail the manner in which the well was plugged, indicating where the mud fluid was placed and the method or methods used in introducing it into the hole. If cement or other plugs were used, state the character of same and depth placed, from feet to feet for each plug set.

Filled hole with heavy mud to 150'. Bridged with hulls and set plug at 135'. Dumped 20 sacks of cement. Filled hole to 30' with mud. Set plug and filled with 10 sacks cement.

10-26-1961
Conservation Division
Wichita, Kansas

(If additional description is necessary, use BACK of this sheet)

Name of Plugging Contractor Terrel Drilling & Producing
Address Russell, Kansas

STATE OF KANSAS, COUNTY OF RUSSELL, ss.
Joe K. Branum (employee of owner) or (owner or operator) of the above-described well, being first duly sworn on oath, says: That I have knowledge of the facts, statements, and matters herein contained and the log of the above-described well as filed and that the same are true and correct. So help me God.

(Signature) Joe K. Branum
754 East Wichita Avenue, Russell, Kansas
(Address)

SUBSCRIBED AND SWORN TO before me this 23rd day of October, 19 61

My commission expires November 13, 1963
Mary Anna Branum Notary Public.

