


STATE OF KANSAS
STATE CORPORATION COMMISSION

Give All Information Completely
Make Required Affidavit
Mail or Deliver Report to:
Conservation Division
State Corporation Commission
800 Bitting Building
Wichita, Kansas

15-183-00009-00-00
WELL PLUGGING RECORD

NORTH

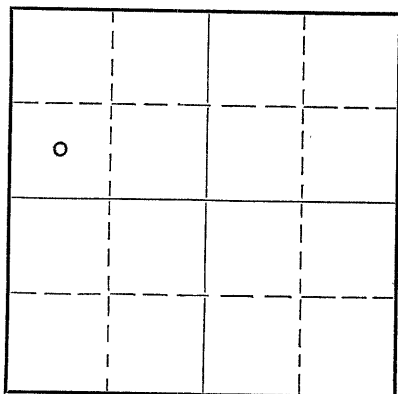

Locate well correctly on above
Section Plat

Smith County, Sec. 5 Twp. 3S Rge. 11 (E) (W)
Location as "NE/CNW $\frac{1}{4}$ SW $\frac{1}{4}$ " or footage from lines SW $\frac{1}{4}$ NW $\frac{1}{4}$
Lease Owner James H. Snowden
Lease Name Lull Well No. 1-5
Office Address 750 West 5th Street, Ft. Worth, Texas
Character of Well (completed as Oil, Gas or Dry Hole) Dry Hole
Date well completed 12-16 19 51
Application for plugging filed 12-16 19 51
Application for plugging approved 12-16 19 51
Plugging commenced 8:00 a.m., 12-16 19 51
Plugging completed 10:00 a.m., 12-16 19 51
Reason for abandonment of well or producing formation Commercial quantity
of oil not found.
If a producing well is abandoned, date of last production 19
Was permission obtained from the Conservation Division or its agents before plugging was commenced? Yes

Name of Conservation Agent who supervised plugging of this well Eldon Petty, Hays, Kansas
Producing formation Depth to top Bottom Total Depth of Well Feet
Show depth and thickness of all water, oil and gas formations.

OIL, GAS OR WATER RECORDS

CASING RECORD

Formation	Content	From	To	Size	Put In	Pulled Out
				8 5/8	213	None

Describe in detail the manner in which the well was plugged, indicating where the mud fluid was placed and the method or methods used in introducing it into the hole. If cement or other plugs were used, state the character of same and depth placed, from feet to feet for each plug set.

Filled hole with heavy mud to 200'. Put in wooden plug and added 50# hulls with 15 sacks cement. Placed second wooden plug at 40', added 50# hulls and capped with 10 sacks cement.

JAN 11 1952
01-11-1952
Conservation Division
Wichita, Kansas

(If additional description is necessary, use BACK of this sheet)

Correspondence regarding this well should be addressed to James H. Snowden
Address 750 West 5th Street, Ft. Worth, Texas

STATE OF KANSAS, COUNTY OF SEDGWICK, ss.
Clinton Engstrand, agent for owner (employee or owner) or (agent or operator) of the above-described well,
being first duly sworn on oath, says: That I have knowledge of the facts, statements, and matters herein contained and the log of the above-described well as filed and that the same are true and correct. So help me God.

(Signature) *Clinton Engstrand*
1006 Central Bldg., Wichita, Kansas
(Address)

SUBSCRIBED AND SWORN TO before me this 10th day of January, 19 52

My commission expires 6-5-54
Notary Public.

28-3273-s 4-50-10M

PLUGGING
FILE NO. 513 R110
PAGE 133 LINE 3