

(00664) - 00-00

15-147-60664-00-00

STATE OF KANSAS  
STATE CORPORATION COMMISSION

FORMATION PLUGGING RECORD

Strike out upper line when reporting plugging off formations.

Give All Information Completely  
Make Required Affidavit  
Mail or Deliver Report to:  
Conservation Division  
State Corporation Commission  
800 Biting Building  
Wichita, Kansas

Phillips County, Sec. 27 Twp 3 Rge 17W (E) (W)

Location as "NE $\frac{1}{4}$ NW $\frac{1}{4}$ SW $\frac{1}{4}$ " or footage from lines SE $\frac{1}{4}$  NW $\frac{1}{4}$

Lease Owner Northern Ordnance

Lease Name Rowland Heirs Well No. 1

Office Address Tulsa, Oklahoma

Character of Well (completed as Oil, Gas or Dry Hole) Dry Hole

Date well completed 3-4-43 19

Application for plugging filed 19

Application for plugging approved 19


Plugging commenced 4-5-43 19

Plugging completed 4-5-43 19

Reason for abandonment of well or producing formation Dry hole

If a producing well is abandoned, date of last production 19

Was permission obtained from the Conservation Division or its agents before plugging was commenced? Yes

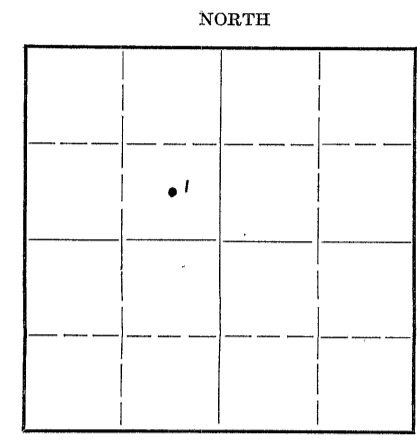

Locate well correctly on above Section Plat

Name of Conservation Agent who supervised plugging of this well C. T. Alexander

Producing formation None Depth to top Bottom Total Depth of Well 3742 Feet

Show depth and thickness of all water, oil and gas formations.



OIL, GAS OR WATER RECORDS

CASING RECORD

Formation	Content	From	To	Size	Put In	Pulled Out
None				10 $\frac{3}{4}$ "	242'	None

Describe in detail the manner in which the well was plugged, indicating where the mud fluid was placed and the method or methods used in introducing it into the hold. If cement or other plugs were used, state the character of same and depth placed, from feet to feet for each plug set.

Mud 3742 to 242'  
Cement 242 to 212' 15 sax  
Mud 212 to 26'  
Cement 26' to 6'  
Mud 6' to Surface

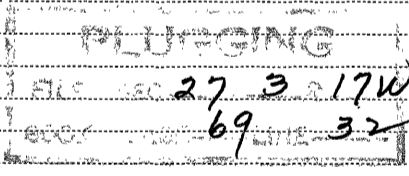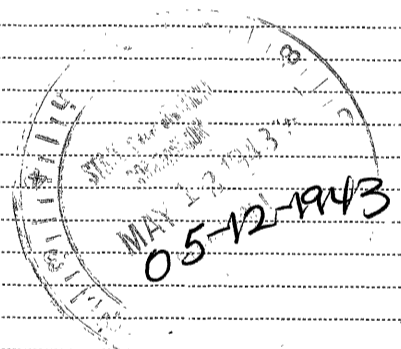

(If additional description is necessary, use BACK of this sheet)

Correspondence regarding this well should be addressed to E. A. Rose  
Address Box 786, Great Bend, Kansas

STATE OF Oklahoma, COUNTY OF Tulsa, ss.  
H. L. Scott (employee of owner) of the above-described well,

being first duly sworn on oath, says: That I have knowledge of the facts, statements, and matters herein contained and the log of the above-described well as filed and that the same are true and correct. So help me God.

(Signature) H. L. Scott

1603 Philtower, Tulsa, Oklahoma (Address)

SUBSCRIBED AND SWORN TO before me this 11th day of May, 1943.

Leleta Walker Notary Public.

My commission expires May 4, 1947