

STATE OF KANSAS  
STATE CORPORATION COMMISSION


Give All Information Completely  
Make Required Affidavit  
Mail or Deliver Report to:  
Conservation Division  
State Corporation Commission  
800 Bitting Building  
Wichita, Kansas

15-147-00029-00-00  
WELL PLUGGING RECORD

OR  
FORMATION PLUGGING RECORD

Strike out upper line  
when reporting plugging  
off formations.

NORTH  
R 16-W

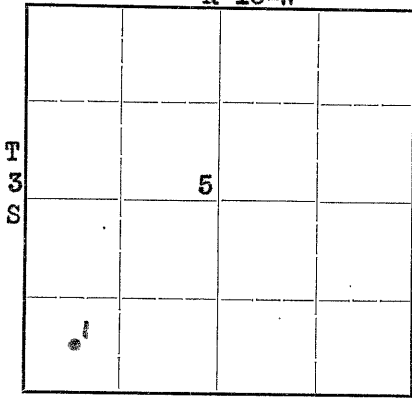

Locate well correctly on above  
Section Plat

Phillips County, Sec. 5 Twp. 3 Rge. (E) 16 (W)

Location as "NE 1/4 NW 1/4 SW 1/4" or footage from lines C SW 1/4 SW 1/4

Lease Owner The Carter Oil Company

Lease Name Grover C. Munyon Well No. 1

Office Address Box 786 Great Bend, Kansas

Character of Well (completed as Oil, Gas or Dry Hole) Dry Hole

Date well completed March 11 19 42

Application for plugging filed 19

Application for plugging approved 19

Plugging commenced March 13 19 42

Plugging completed March 13 19 42

Reason for abandonment of well or producing formation Dry hole

If a producing well is abandoned, date of last production 19

Was permission obtained from the Conservation Division or its agents before plugging was commenced? Yes

Name of Conservation Agent who supervised plugging of this well B. T. Alexander

Producing formation Depth to top Bottom Total Depth of Well 3926 Feet

Show depth and thickness of all water, oil and gas formations.


OIL, GAS OR WATER RECORDS

CASING RECORD

Formation	Content	From	To	Size	Put In	Pulled Out
Topeka	Dry	2,961		8-5/8"	273'	None
Kansas City	Dry	3,229				
Viola	Dry	3,725				
Simpson	Dry	3,851				
Arbuckle	Dry	3,892				

Describe in detail the manner in which the well was plugged, indicating where the mud fluid was placed and the method or methods used in introducing it into the hole. If cement or other plugs were used, state the character of same and depth placed, from feet to feet for each plug set.

The hole was filled with 14.3#/gal. mud from bottom to bottom of the surface pipe at 273'.  
Placed wood plug in bottom of 8-5/8" casing with 32 feet of cement on top of wood plug. Bottom plug from 239' to 273'.  
Placed 32 feet of cement in top of casing with 14.3 pound mud between plugs.

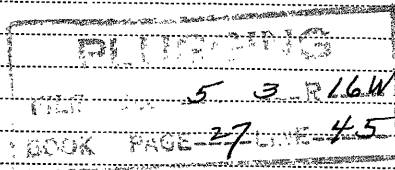

(If additional description is necessary, use BACK of this sheet)

Correspondence regarding this well should be addressed to The Carter Oil Company  
Address Box 786, Great Bend, Kansas

STATE OF Kansas COUNTY OF Barton, ss.  
E. A. Rose (employee of owner) or (owner or operator) of the above-described well,

being first duly sworn on oath, says: That I have knowledge of the facts, statements, and matters herein contained and the log of the above-described well as filed and that the same are true and correct. So help me God.

(Signature) E. A. Rose

03-27-1942  
(Address)

SUBSCRIBED AND SWORN to before me this 26 day of March, 1942

My commission expires April 16, 1944

Notary Public.

