

car

For KCC Use: Effective Date: 12-10-00 District # 4 SGA?  Yes  No

KANSAS CORPORATION COMMISSION OIL & GAS CONSERVATION DIVISION

Form C-1 September 1999 Form must be Typed Form must be Signed All blanks must be Filled

NOTICE OF INTENT TO DRILL

Must be approved by KCC five (5) days prior to commencing well

Expected Spud Date 12 28 2000 month day year

Spot SW NW SW Sec. 23 Twp. 3S S. R. 19W  East  West 1650 feet from Ⓢ / \*\* (circle one) Line of Section 4950 feet from Ⓢ / \*\* (circle one) Line of Section Is SECTION  Regular  Irregular?

OPERATOR: License# 5011 Name: Viking Resources, Inc. Address: 105 S. Broadway, Ste. 1040 City/State/Zip: Wichita, KS 67202 Contact Person: Shawn P. Devlin Phone: 316-262-2502

(Note: Locate well on the Section Plat on reverse side) County: Phillips Lease Name: Ehm Well #: 3 Field Name: Stuttgart

CONTRACTOR: License# 30606 Name: Murfin Drilling, Inc.

Is this a Prorated / Spaced Field?  Yes  No Target Formation(s): LKC Nearest Lease or unit boundary: 330

Well Drilled For:  Oil  Gas  OWWO  Seismic; # of Holes  Other  Enh Rec  Storage  Disposal  Other Well Class:  Infield  Pool Ext.  Wildcat  Other Type Equipment:  Mud Rotary  Air Rotary  Cable

Ground Surface Elevation: 2067 feet MSL Water well within one-quarter mile:  Yes  No Public water supply well within one mile:  Yes  No Depth to bottom of fresh water: 180 Depth to bottom of usable water: 980 Surface Pipe by Alternate: 1  2 Length of Surface Pipe Planned to be set: 200

If OWWO: old well information as follows: Operator: Well Name: Original Completion Date: Original Total Depth:

Length of Conductor Pipe required: None Projected Total Depth: 3500 Formation at Total Depth: LKC

Directional, Deviated or Horizontal wellbore?  Yes  No If Yes, true vertical depth: Bottom Hole Location: KCC DKT #:

Water Source for Drilling Operations: Well  Farm Pond  Other  DWR Permit #: Will Cores be taken?  Yes  No If Yes, proposed zone:

WAS: G.L. 2000'

AFFIDAVIT

The undersigned hereby affirms that the drilling, completion and eventual plugging of this well will comply with K.S.A. 55-101, et. seq. It is agreed that the following minimum requirements will be met:

- 1. Notify the appropriate district office prior to spudding of well;
2. A copy of the approved notice of intent to drill shall be posted on each drilling rig;
3. The minimum amount of surface pipe as specified below shall be set by circulating cement to the top; in all cases surface pipe shall be set through all unconsolidated materials plus a minimum of 20 feet into the underlying formation.
4. If the well is dry hole, an agreement between the operator and the district office on plug length and placement is necessary prior to plugging;
5. The appropriate district office will be notified before well is either plugged or production casing is cemented in;
6. If an ALTERNATE II COMPLETION, production pipe shall be cemented from below any usable water to surface within 120 days of spud date. In all cases, NOTIFY district office prior to any cementing.

I hereby certify that the statements made herein are true and to the best of my knowledge and belief.

Date: 12/28/00 Signature of Operator or Agent: Shawn P. Devlin Title: Vice President

For KCC Use ONLY API # 15 - 147-20598-0000 Conductor pipe required None feet Minimum surface pipe required 200' feet per Alt.  (2) Approved by: J.P.W. 12-29-00 / O.R.L.G. JK 12-5-2000 This authorization expires: 6-5-2001 (This authorization void if drilling not started within 6 months of effective date.) Spud date: Agent:

- Remember to: - File Drill Pit Application (form CDP-1) with Intent to Drill; - File Completion Form ACO-1 within 120 days of spud date; - File acreage attribution plat according to field proration orders; - Notify appropriate district office 48 hours prior to workover or re-entry; - Submit plugging report (CP-4) after plugging is completed; - Obtain written approval before disposing or injecting salt water.

RECEIVED KANSAS CORPORATION COMMISSION

Mail to: KCC - Conservation Division, 130 S. Market - Room 2078, Wichita, Kansas 67202

DEC 29 2000

CONSERVATION DIVISION WICHITA, KS

23 3 163

**IN ALL CASES PLOT THE INTENDED WELL ON THE PLAT BELOW**

*Plat of acreage attributable to a well in a prorated or spaced field*

*If the intended well is in a prorated or spaced field, please fully complete this side of the form. If the intended well is in a prorated or spaced field complete the plat below showing that the well will be properly located in relationship to other wells producing from the common source of supply. Please show all the wells and within 1 mile of the boundaries of the proposed acreage attribution unit for gas wells and within 1/2 mile of the boundaries of the proposed acreage attribution unit for oil wells.*

API No. 15 - \_\_\_\_\_  
Operator: Viking Resources, Inc.  
Lease: Ehm  
Well Number: 3  
Field: Stuttgart

Location of Well: County: Phillips  
1650 feet from  S /  N (circle one) Line of Section  
4950 feet from  E /  W (circle one) Line of Section  
Sec. 23 Twp. 3S S. R. 19W  East  West

Number of Acres attributable to well: \_\_\_\_\_  
QTR / QTR / QTR of acreage: SW-NW-SW



Is Section  Regular or \_\_\_\_\_ Irregular

**If Section is Irregular, locate well from nearest corner boundary.**

Section corner used:  NE  NW  SE  SW

**PLAT**

*(Show location of the well and shade attributable acreage for prorated or spaced wells.)  
(Show footage to the nearest lease or unit boundary line.)*

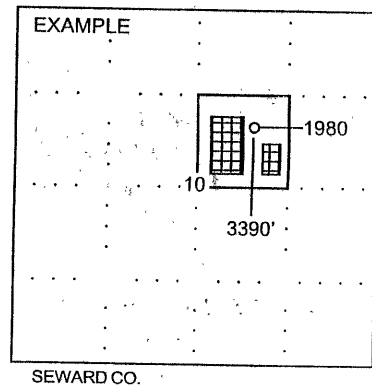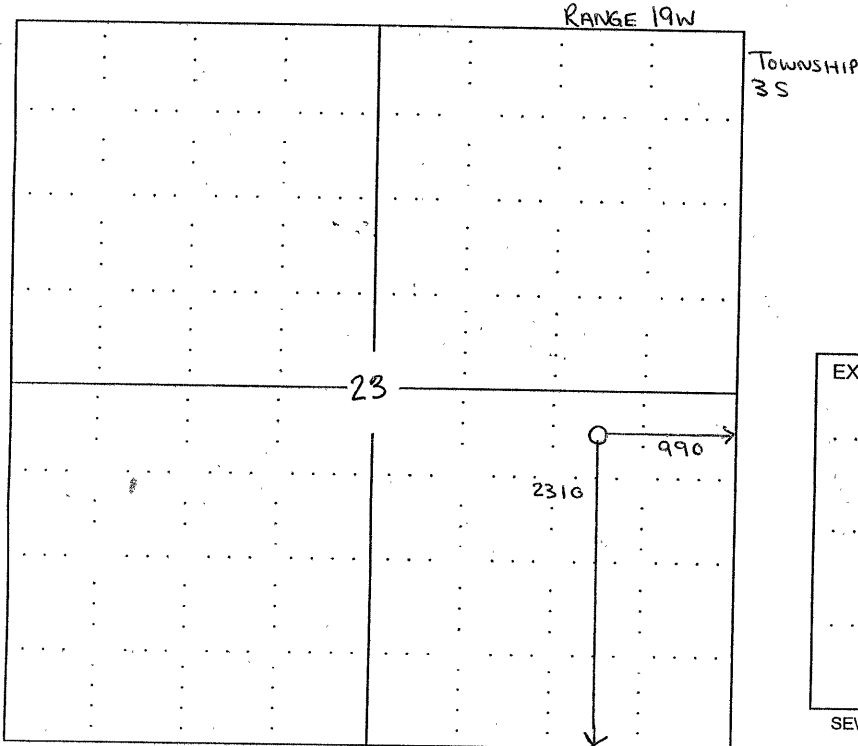

**NOTE: In all cases locate the spot of the proposed drilling location.**

**In plotting the proposed location of the well, you must show:**

1. The manner in which you are using the depicted plat by identifying section lines, i.e. 1 section, 1 section with 8 surrounding sections, 4 sections, etc.
2. The distance of the proposed drilling location from the section's south / north and east / west.
3. The distance to the nearest lease or unit boundary line.
4. If proposed location is located within a prorated or spaced field a certificate of acreage attribution plat must be attached: (CO-7 for oil wells; CG-8 for gas wells).