

FOR KCC USE:

FORM C-1 7/94

EFFECTIVE DATE: 6-1-94

FORM MUST BE TYPED

DISTRICT # 4

FORM MUST BE SIGNED

SSAT Yes No

State of Kansas  
NOTICE OF INTENTION TO DRILL

ALL BLANKS MUST BE FILLED

Must be approved by the K.C.C. five (5) days prior to commencing well

Expected Spud Date 6 15 94  
month day year

Spot SW SE SW 23 East  
Sec Twp 3 S. Rg 19 X West

OPERATOR: License # 5011  
Name: Viking Resources, Inc.  
Address: 105 S. Broadway, Ste. 1040  
City/State/Zip: Wichita, KS. 67202  
Contact Person: Shawn Devlin  
Phone: 316-262-2502

330 feet from South North line of Section  
3630 feet from East West line of Section  
IS SECTION X REGULAR IRREGULAR?

(NOTE: Locate well on the Section Plat on Reverse Side)

County: Phillips  
Lease Name: Ehm Well #: 1  
Field Name: Stuttgart

CONTRACTOR: License #: 30606  
Name: Murfin Drilling

Is this a Prorated/Spaced Field? ... yes X no  
Target Formation(s): LKC  
Nearest Lease or unit boundary: 330

Well Drilled For: Well Class: Type Equipment:

- Oil
- Gas
- CWUD
- Seismic
- Other
- Enh Rec
- Storage
- Disposal
- # of Holes
- Infield
- Pool Ext.
- Wildcat
- Other
- Mud Rotary
- Air Rotary
- Cable

Ground Surface Elevation: 2050 est. feet MSL  
Public well within one-quarter mile: ... yes X no  
Public water supply well within one mile: ... yes X no

If CWUD: old well information as follows:  
Operator:  
Well Name:  
Comp. Date: Old Total Depth

Depth to bottom of fresh water: 60  
Depth to bottom of usable water: 990-950  
Surface Pipe by Alternate: 1 X 2  
Length of Surface Pipe Planned to be set: 200  
Length of Conductor pipe required: none  
Projected Total Depth: 3550  
Formation at Total Depth: Arb.

Directional, Deviated or Horizontal wellbore? ... yes X no  
If yes, true vertical depth:  
Bottom Hole Location:

Water Source for Drilling Operations:  
... well X farm pond X other  
DWR Permit #:   
Will Cores Be Taken? ... yes X no  
If yes, proposed zone:

AFFIDAVIT

The undersigned hereby affirms that the drilling, completion and eventual plugging of this well will comply with K.S.A. 55-101, et. seq.  
It is agreed that the following minimum requirements will be met:

1. Notify the appropriate district office prior to spudding of well;
2. A copy of the approved notice of intent to drill shall be posted on each drilling rig;
3. The minimum amount of surface pipe as specified below shall be set by circulating cement to the top; in all cases surface pipe shall be set through all unconsolidated materials plus a minimum of 20 feet into the underlying formation;
4. If the well is dry hole, an agreement between the operator and the district office on plug length and placement is necessary prior to plugging;
5. The appropriate district office will be notified before well is either plugged or production casing is cemented in;
6. IF AN ALTERNATE II COMPLETION, PRODUCTION PIPE SHALL BE CEMENTED FROM BELOW ANY USABLE WATER TO SURFACE WITHIN 120 DAYS OF SPUD DATE. IN ALL CASES, NOTIFY DISTRICT OFFICE PRIOR TO ANY CEMENTING.

I hereby certify that the statements made herein are true and to the best of my knowledge and belief.  
Date: 5.12.5.194 Signature of Operator or Agent: Shawn P. Devlin Title: Vice President

FOR KCC USE:  
API # 15- 147-20557-00-00  
Conductor pipe required NONE feet  
Minimum surface pipe required 200 feet per Alt. X 2  
Approved by: CB 5-27-94  
This authorization expires: 11-27-94  
(This authorization void if drilling not started within 6 months of effective date.)  
Spud date: \_\_\_\_\_ Agent: \_\_\_\_\_

REMEMBER TO:

- File Drill Pit Application (form CDP-1) with Intent to Drill;
- File Completion Form ACO-1 within 120 days of spud date;
- File acreage attribution plat according to field proration orders;
- Notify appropriate district office 48 hours prior to workover or re-entry;
- Submit plugging report (CP-4) after plugging is completed;
- Obtain written approval before disposing or injecting salt water.

Mail to: Conservation Division, 200 Colorado Derby Building, 202 W. First St., Wichita, Kansas 67202-1286.

RECEIVED  
STATE CORPORATION COMMISSION

MAY 27 1994

CONSERVATION DIVISION  
Wichita, Kansas

IN ALL CASES PLOT THE INTENDED WELL ON THE PLAT BELOW

PLAT OF ACREAGE ATTRIBUTABLE TO A WELL IN A PRORATED OR SPACED FIELD

If the intended well is in a prorated or spaced field, please fully complete this side of the form. If the intended well is in a prorated or spaced field complete the plat below showing that the well will be properly located in relationship to other wells producing from the common source of supply. Please show all the wells within 1 mile of the boundaries of the proposed acreage attribution unit for gas wells and within 1/2 mile of the boundaries of the proposed acreage attribution unit for oil wells.

API NO. 15- \_\_\_\_\_  
 OPERATOR Viking Resources, Inc.  
 LEASE Ehm  
 WELL NUMBER 1  
 FIELD Stuttgart



LOCATION OF WELL: COUNTY Phillips  
330 feet from south/north line of section  
3630 feet from east/west line of section  
 SECTION 23 TWP 3 RG 19

NUMBER OF ACRES ATTRIBUTABLE TO WELL \_\_\_\_\_  
 QTR/QTR/QTR OF ACREAGE SW - SE - SW

IS SECTION X REGULAR or \_\_\_\_\_ IRREGULAR  
IF SECTION IS IRREGULAR, LOCATE WELL FROM NEAREST CORNER BOUNDARY.

Section corner used: \_\_\_\_\_ NE \_\_\_\_\_ NW \_\_\_\_\_ SE \_\_\_\_\_ SW  
**PLAT**

(Show location of the well and shade attributable acreage for prorated or spaced wells.)  
 (Show footage to the nearest lease or unit boundary line.)

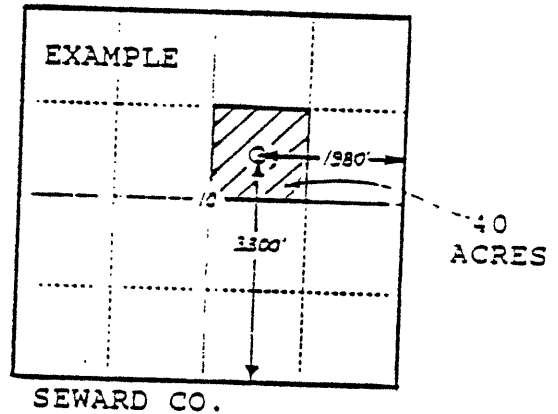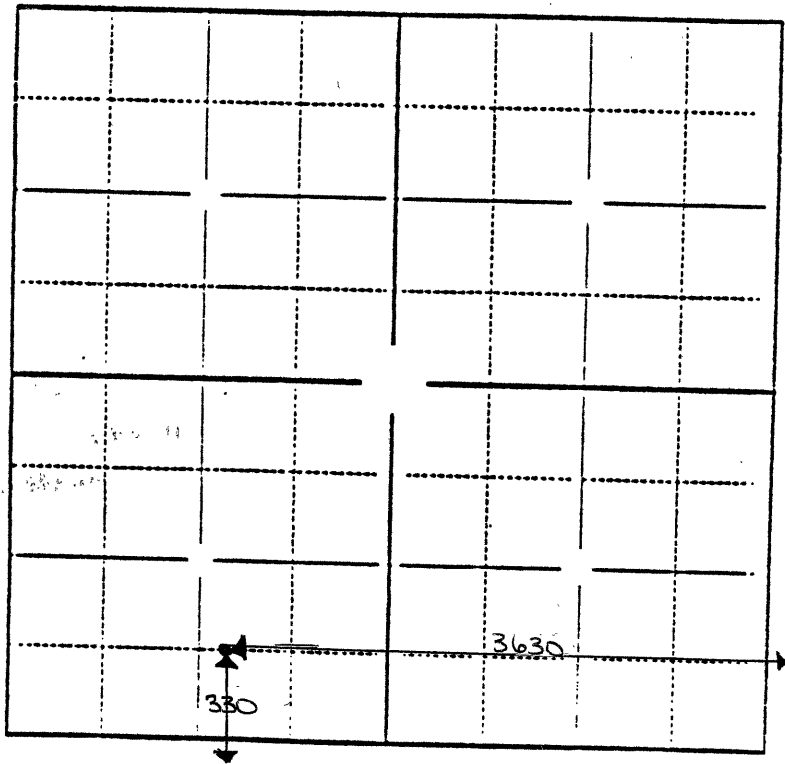

In plotting the proposed location of the well, you must show:

- 1) The manner in which you are using the depicted plat by identifying section lines, i.e. 1 section, 1 section with 8 surrounding sections, 4 sections, etc.;
- 2) the distance of the proposed drilling location from the section's south/north and east/west lines; and
- 3) the distance to the nearest lease or unit boundary line.