

15-147-20050-00-00


STATE OF KANSAS
STATE CORPORATION COMMISSION

Form CP-4

Give All Information Completely
Make Required Affidavit
Mail or Deliver Report to:
Conservation Division
State Corporation Commission
212 No. Market
Wichita, Kansas

WELL PLUGGING RECORD

NORTH

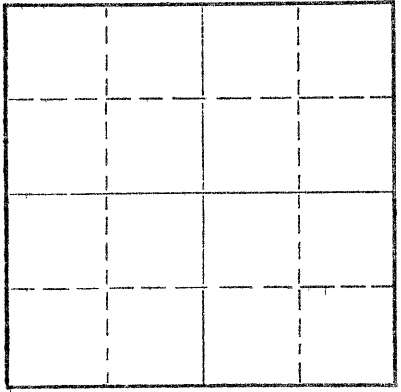

Locate well correctly on above
Section Plat

Phillips County. Sec. 33 Twp. 3 Rge. 18 (E)W (W)
Location as "NE/CNWxSWx" or footage from lines NE SW SW
Lease Owner Beacon Resources Corporation
Lease Name Zillinger A Well No. 1
Office Address 312 Union Center, Wichita, Kansas 67202
Character of Well (completed as Oil, Gas or Dry Hole) Dry Hole
Date well completed 10-26 19 68
Application for plugging filed 10-26 19 68
Application for plugging approved 10-26 19 68
Plugging commenced 10-26 19 68
Plugging completed 10-26 19 68
Reason for abandonment of well or producing formation Dry Hole

If a producing well is abandoned, date of last production 19
Was permission obtained from the Conservation Division or its agents before plugging was commenced? Yes

Name of Conservation Agent who supervised plugging of this well Leo Massey
Producing formation Depth to top Bottom Total Depth of Well Feet
Show depth and thickness of all water, oil and gas formations.

OIL, GAS OR WATER RECORDS

CASING RECORD

FORMATION	CONTENT	FROM	TO	SIZE	PUT IN	PULLED OUT
Surface Pipe				8 5/8"	252'	

Describe in detail the manner in which the well was plugged, indicating where the mud fluid was placed and the method or methods used in introducing it into the hole. If cement or other plugs were used, state the character of same and depth placed, from feet to feet for each plug set.

1st. plug was set @ 800' with 70 sacks cement
2nd. plug was set @ 240' with 20 sacks cement
3rd. plug was set @ 40' with 10 sacks cement
Cementing to bottom of cellar

RECEIVED
STATE CORPORATION COMMISSION
OCT 30 1968
CONSERVATION DIVISION
Wichita, Kansas


10-30-68

(If additional description is necessary, use BACK of this sheet)

Name of Plugging Contractor L. J. Dreiling & Sons, Inc.
Address Route 2, Victoria, Kansas 67671

STATE OF KANSAS, COUNTY OF ELLIS, ss.
I, Leo F. Dreiling (employee of owner) or (owner) of the above-described well, being first duly sworn on oath, says: That I have knowledge of the facts, statements, and matters herein contained and the log of the above-described well as filed and that the same are true and correct. So help me God.

(Signature) Leo F. Dreiling
LEO F. DREILING, ROUTE 2, VICTORIA, KANSAS 67671
(Address)

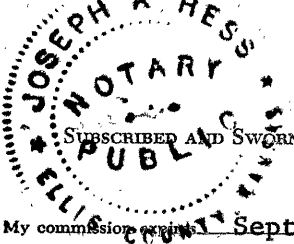

Subscribed and Sworn to before me this 29th day of October, 1968
Joseph A. Hess
Notary Public.

My commission expires September 19, 1970

15-147-20050-00-00

L. J. DREILING AND SONS, INC.

Victoria, Kansas 67671

WELL LOG

Company	Beacon Resources Corporation 312 Union Center Wichita, Kansas 67202	Sec. 33	Twp. 3	Rng. 18
Farm	Zillinger A No. 1	Location	NE SW SW	
Total Depth	3580'	County	Phillips	
Comm.	10-18-68	Comp.	10-26-68	Elevation: 1925' K. B.
Contractor	L. J. Dreiling & Sons, Inc. Victoria, Kansas 67671			1922' D. F.
	Casing Record	Cement Record		1920' G. R.
	252' - 8 5/8"	160 sacks cement		Production: D & A

Figures Indicate Bottom of Formations

0'	40'	Surface Soil & Clay
40'	140'	Clay & Sand Streaks
140'	252'	Blue Shale
252'	832'	Shale
832'	860'	Hard Sand
860'	960'	Shale & Sand Streaks
960'	1183'	Sand
1183'	1498'	Shale & Redbed
1498'	1538'	Anhy.
1538'	1770'	Shale & Lime Streaks
1770'	2055'	Shale & Lime Shell
2055'	2780'	Lime & Shale
2780'	2887'	Lime
2887'	3015'	Lime & Shale
3015'	3580'	Lime
3580'	T.D.	

STATE OF KANSAS)
)ss
 COUNTY OF ELLIS)

I, Leo F. Dreiling, of the L. J. Dreiling & Sons, Inc., upon oath states that the above and foregoing is a true and correct copy from the Daily Drilling Report from your Zillinger A #1.

Leo F. Dreiling

 LEO F. DREILING

Subscribed and sworn to before me this 29th day of October 1968.

Joseph A. Hess

 JOSEPH A. HESS NOTARY PUBLIC



My commission expires: September 19, 1970