


Give All Information Completely
Make Required Affidavit
Mail or Deliver Report to:
Conservation Division
State Corporation Commission
800 Bitting Building
Wichita, Kansas

WELL PLUGGING RECORD

NORTH

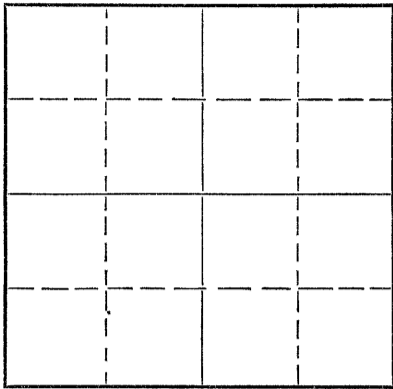

Locate well correctly on above
Section Flat

Phillips County. Sec. 33 Twp. 3 Rge. 18 (W)
Location as "NE/CNW $\frac{1}{4}$ SW $\frac{1}{4}$ " or footage from lines SW NW NE
Lease Owner Sohio Petroleum Company
Lease Name Hansen Well No. 1
Office Address P. O. Box 673, Russell, Kansas
Character of Well (completed as Oil, Gas or Dry Hole) Dry Hole
Date well completed 12-2 1952
Application for plugging filed 12-3 1952
Application for plugging approved Verbal from Eldon Petty 12-2 1952
Plugging commenced 12-2 1952
Plugging completed 12-2 1952
Reason for abandonment of well or producing formation Dry

If a producing well is abandoned, date of last production 19
Was permission obtained from the Conservation Division or its agents before plugging was commenced? Yes

Name of Conservation Agent who supervised plugging of this well Eldon Petty
Producing formation Depth to top Bottom Total Depth of Well Feet
Show depth and thickness of all water, oil and gas formations.

OIL, GAS OR WATER RECORDS

CASING RECORD

Formation	Content	From	To	Size	Put In	Pulled Out
		Surface	299' R.B.	8-5/8"	311.11'	None

Describe in detail the manner in which the well was plugged, indicating where the mud fluid was placed and the method or methods used in introducing it into the hole. If cement or other plugs were used, state the character of same and depth placed, from feet to feet for each plug set.

Heavy mud to 270' - Bridged hole in surface casing at 270' &
cemented on bridge w/15 sax cement filled w/heavy mud to 40' -
Bridged hole at 40' w/Halliburton plug - placed $\frac{1}{2}$ sack hulls
on top & cemented to within 12" below ground level w/10 sax cement.

(If additional description is necessary, use BACK of this sheet)

Name of Plugging Contractor Schafer Drilling Company
Address Pratt, Kansas

STATE OF KANSAS, COUNTY OF russell, ss.
J. H. Bond (employee of owner) of the above-described well,
being first duly sworn on oath, says: That I have knowledge of the facts, statements, and matters herein contained and the log of the above-described well as filed and that the same are true and correct. So help me God.


(Signature) J. H. Bond
(Address)

SUBSCRIBED AND SWORN to before me this 5th day of December, 1952

Charles Miller
Notary Public.

My commission expires July 2, 1953

28-8390-s 6-51-20M

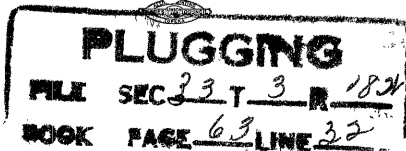

CONSERVATION DIVISION
Wichita, Kansas

12-8-52

15-147-00106-00-00

LOG: Well #1, HANSEN #1, Phillips County

SOHIO OIL COMPANY

0 to 15'	Surface soil
15 to 235'	Shale, shells & sand
235 to 300'	Shale & shells
300 to 695'	Shale
695 to 770'	Red bed
770 to 835'	Pyrite & sand
835 to 1305'	Sand & shale
1305 to 1475'	Shale, shells & sand
1475 to 1520'	Lime (anhydrite)
1520 to 1715'	Shale & shells
1715 to 1950'	Shale
1950 to 2745'	Shale & lime
2745 to 3302'	Lime
3302 to 3319'	Lime & shale
3319 to 3537'	Lime
3537 to 3594'	Cherty lime

PLUGGING

MINERAL
 STATE SURVEY COMMISSION
 12-8-52
 CONSERVATION DIVISION
 Wichita, Kansas