

15-147-00665-00-00

STATE OF KANSAS  
STATE CORPORATION COMMISSION


WELL PLUGGING RECORD

OR  
FORMATION PLUGGING RECORD

Strike out upper line when reporting plugging of formations.

Give All Information Completely  
Make Required Affidavit  
Mail or Deliver Report to:  
Conservation Division  
State Corporation Commission  
800 Bitting Building  
Wichita, Kansas

Phillips County, Sec. 17, Twp. 3 S, Rge. 18, ~~EX. W~~ (W)  
Location as "NE $\frac{1}{4}$ NW $\frac{1}{4}$ SW $\frac{1}{4}$ " or footage from lines Center SW $\frac{1}{4}$  NE $\frac{1}{4}$   
Lease Owner Davis & Childs  
Lease Name P. Beyerlein Well No. 1  
Office Address Hutchinson, Kansas  
Character of Well (completed as Oil, Gas or Dry Hole) DRY  
Date well completed January 11 19 43  
Application for plugging filed January 19 19 43  
Application for plugging approved January 19 43  
Plugging commenced January 12 19 43  
Plugging completed January 12 19 43  
Reason for abandonment of well or producing formation All formations dry

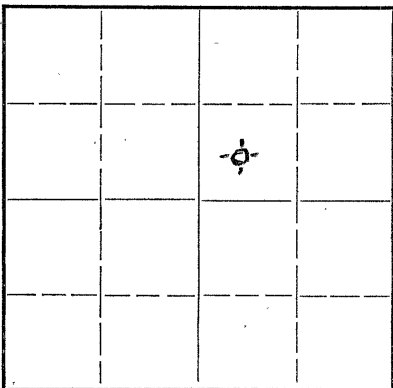

Locate well correctly on above Section Plat

If a producing well is abandoned, date of last production 19...  
Was permission obtained from the Conservation Division or its agents before plugging was commenced? Permission was obtained from C. T. Alexander

Name of Conservation Agent who supervised plugging of this well C. T. Alexander  
Producing formation... Depth to top... Bottom... Total Depth of Well 3656 Feet  
Show depth and thickness of all water, oil and gas formations.

OIL, GAS OR WATER RECORDS

CASING RECORD

Formation	Content	From	To	Size	Put In	Pulled Out
Sand & shale		9	190	10	155	Cemented

Describe in detail the manner in which the well was plugged, indicating where the mud fluid was placed and the method or methods used in introducing it into the hole. If cement or other plugs were used, state the character of same and depth placed, from... feet to... feet for each plug set.  
Heavy mud circulated in hole from 3656 to 155. Hole bridged and cemented from 155 to 120 through drill pipe. Mud from 120 to 26. Cement from 26' to 6' and soil from 6' to 0

17 3 18W Pd.  
60 41 1/20/43 Ha.

(If additional description is necessary, use BACK of this sheet)

Correspondence regarding this well should be addressed to Davis & Childs  
Address Hutchinson, Kansas

STATE OF Kansas, COUNTY OF Sedgwick, ss.  
H. M. Williams (employee of owner) or (owner or operator) of the above-described well,  
being first duly sworn on oath, says: That I have knowledge of the facts, statements, and matters herein contained and the log of the above-described well as filed and that the same are true and correct. So help me God.

(Signature) *H. M. Williams Operator*

701 Bitting Bldg., Wichita, Kansas  
(Address)

SUBSCRIBED AND SWORN to before me this 19 day of January 19 43

My commission expires March 4, 1944

*Deulah Lehr*  
Notary Public.

1-21-43

15-147-00065-00-00

PAUL BEYERLEIN WELL NO. 1

COMPANY	DRILLING BEGAN	LOCATION	10" SURFACE CASING	ELEVATION
Davis & Childs	12-24-1942	0 SW NE 17-35-18W	155'	1960
DRILLING CONT.	DRILLING COMP.	Phillips County	CEMENT	ABANDONED
H. M. Williams	1-11-1945	Kansas	125 sacks	1-12-1945
				DRY

FORMATIONS

Soil	9
sand & shale	190
shale	450
shale & shells	929
sand & shells	965
shale & shells	1195
sand	1275
lime	1295
lime & sand	1530
lime	1555
red bed, shale & shells	1675
shale & shells	2160
lime & shale	2513
lime, shale & pyrites	2550
lime & shale	2772
sandy shale	2808
shale & shells	2920
sand & shells	2944
sandy lime	2980
lime	3034 Top Topeka 2975'
soft white lime	3038
cherty lime	3070
soft white lime	3080
cherty lime	3176
black shale	3179
cherty lime	3215
red shale	3217 Top Lansing-Kansas City 3217'
crystalline lime & red shale	3253 Slight oil stains 3217' to 3218'
lime	3282 " " " 3253' to 3254'
cherty lime & red shale	3352
cherty hard lime	3359
cherty lime	3390
lime with red & green shale	3424 Top Marmaton 3424'
shale	3440
gray nodular lime	3455
pink, yellow & gray nodular lime	3480
red shale	3495
gray non-porous oolitic lime	3510
red, purple & green shale	3525
gray & yellow nodular lime	3545
lime, dolomite, red & green shale	3584
conglomerate	3602 Top Conglomerate 3584'
Arbuckle lime	3656 Top Arbuckle 3602'
Total depth	3656

State of Kansas }  
 County of Sedgwick } SS

17 3 18W  
 60 41

This is to certify that the above is a true and correct copy of the log of the above well

Subscribed and sworn to before me, a notary public, this 16 day of January, 1945

My Commission expires March 4th, 1944

*J. Decker*  
 Notary Public

1-21-43