

15-147-00669-00-00

STATE OF KANSAS  
STATE CORPORATION COMMISSION

WELL PLUGGING RECORD

OR  
FORMATION PLUGGING RECORD


Strike out upper line  
when reporting plugging  
off formations.

Give All Information Completely  
Make Required Affidavit  
Mail or Deliver Report to:  
Conservation Division  
State Corporation Commission  
800 Biting Building  
Wichita, Kansas

Phillips County. Sec. 11 Twp. 3 Rge. 19 (E) W (W)

Location as "NE $\frac{1}{4}$ NW $\frac{1}{4}$ SW $\frac{1}{4}$ " or footage from lines Center SE SE  
Lease Owner Allan & Cohen  
Lease Name Vogel Well No. 1  
Office Address 921 Union National Bank Bldg., Wichita, Kansas  
Character of Well (completed as Oil, Gas or Dry Hole) Dry Hole  
Date well completed November 25 19 42  
Application for plugging filed November 25 19 42  
Application for plugging approved November 25 19 42  
Plugging commenced November 25 19 42  
Plugging completed November 26 19 42  
Reason for abandonment of well or producing formation No Oil

NORTH

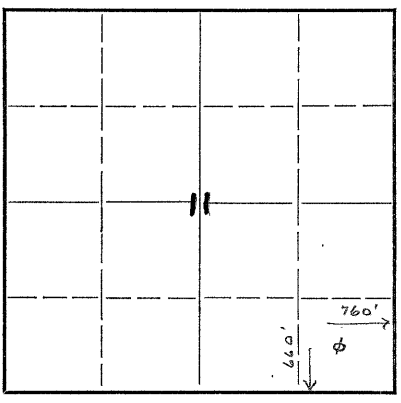

Locate well correctly on above  
Section Plat

If a producing well is abandoned, date of last production 19  
Was permission obtained from the Conservation Division or its agents before plugging was commenced? Yes

Name of Conservation Agent who supervised plugging of this well C. T. Alexander  
Producing formation Lansing-Kansas City Depth to top 3164 Bottom 3430 Total Depth of Well 3430 Feet  
Show depth and thickness of all water, oil and gas formations.


OIL, GAS OR WATER RECORDS

CASING RECORD

Formation	Content	From	To	Size	Put In	Pulled Out
Drilled by Rotary - See sample log attached.						

Describe in detail the manner in which the well was plugged, indicating where the mud fluid was placed and the method or methods used in introducing it into the hold. If cement or other plugs were used, state the character of same and depth placed, from feet to feet for each plug set.

Heavy Rotary mud from 3430 to base of surface pipe  
Plug at 93 feet  
12 sacks cement  
Mud to 18 feet  
Cement to 6 feet of top of hole

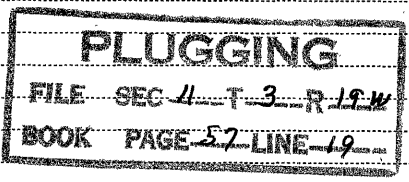

12-3-42

(If additional description is necessary, use BACK of this sheet)

Correspondence regarding this well should be addressed to Thos. H. Allan  
Address 921 Union National Bank Bldg., Wichita, Kansas

STATE OF Kansas, COUNTY OF Sedgwick, ss.  
Thos. H. Allan (employee or owner) of (owner or operator) of the above-described well,

being first duly sworn on oath, says: That I have knowledge of the facts, statements, and matters herein contained and the log of the above-described well as filed and that the same are true and correct. So help me God.

(Signature) Thos. H. Allan

921 Union National Bank Bldg., Wichita, Kansas  
(Address)

SUBSCRIBED AND SWORN to before me this 30th day of November, 19 42

Ruth Newcomer  
Notary Public.

My commission expires February 7, 1944.

Casing Record

15-147-00669-00-00

Phillips County, Kansas

8-5/8" @ 95'

Allan & Cohen #1 Vogel

Loc: C SE SE Sec. 11, T. 3S., R. 19W.

Commenced: 11/9/42 Completed: 11/26/42

Contractor: Thos. H. Allan

I.P. Dry & Abandoned

Elevation: 2042

Time log and samples taken thru anhydrite and Fort Riley zones and from 2900' down.

0 - 95	surface soil and shale	5430	shale
	Cemented 8-5/8" casing w/ 35 sacks	5430	Total Depth
1552	sandy shale & red beds		
1560	anhydrite		
2125	shale		
2145	porous limestone - Fort Riley		
2952	shale & lime shells		
2954	lime - Topeka		
2950	shale		
2960	lime		
2975	shale		
2980	lime		
2985	shale		
5002	cherty lime		
5014	shale		
5024	lime		
5052	very soft sandy dolomitic lime		
5065	shale		
5088	lime		
5095	shale		
5158	lime		
5144	shale		
5147	lime		
5164	shale		
5172	cherty white lime - Dayton Lansing		
5185	shale		
5208	dense white lime		
5216	red shale		
5226	white cherty lime		
5235	red & green shale		
5240	cherty lime		
5260	white dense lime		
5265	dense oolitic lime		
5290	lime		
5295	shale		
5300	lime		
5314	shale		
5325	cherty lime - Oil stained		
5356	shale		
5343	lime - Oil stained		
5352	red shale		
5352	dense buff lime		
5378	shale		
5395	lime		
5400	shale		
5410	lime		
5415	shale		
5426	red sandy grit		

**PLUGGING**  
 FILE SEC 11 T 3 R 19W  
 BOOK PAGE 57 LINE 19

I certify that the above is a true and correct copy of well log on the above test.

Thos. H. Allan

12-3-42