


15-147-00886-00-00

STATE OF KANSAS
STATE CORPORATION COMMISSION

Give All Information Completely
Make Required Affidavit
Mail or Deliver Report to:
Conservation Division
State Corporation Commission
800 Bitting Building
Wichita, Kansas

WELL PLUGGING RECORD

NORTH

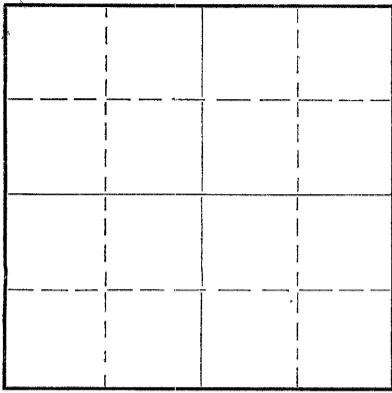

Locate well correctly on above
Section Plat

Phillips County. Sec. 2 Twp. 3S Rge. (E) 19 (W)
Location as "NE/CNW 1/4 SW 1/4" or footage from lines SW NW (1), S/2 NE (2)
Lease Owner The Carter Oil Co.
Lease Name F. H. Eltiste Well No. 1
Office Address Box 786, Great Bend, Kansas
Character of Well (completed as Oil, Gas or Dry Hole) Oil
Date well completed July 24, 19 42
Application for plugging filed March 2, 19 49
Application for plugging approved March 5, 19 49
Plugging commenced January 23, 19 51
Plugging completed January 31, 19 51
Reason for abandonment of well or producing formation Unprofitable to operate
If a producing well is abandoned, date of last production December 28 19 50
Was permission obtained from the Conservation Division or its agents before plugging was commenced? Yes

Name of Conservation Agent who supervised plugging of this well Eldon Petty
Producing formation Ks. City Limestone Depth to top Bottom Total Depth of Well 3310 Feet
Show depth and thickness of all water, oil and gas formations.

OIL, GAS OR WATER RECORDS

CASING RECORD

Formation	Content	From	To	Size	Put In	Pulled Out
Kansas City Limestone				8-5/8"	270'	None
				5-1/2"	3308'	975'

Describe in detail the manner in which the well was plugged, indicating where the mud fluid was placed and the method or methods used in introducing it into the hole. If cement or other plugs were used, state the character of same and depth placed, from feet to feet for each plug set.

Previous P.B. with cement from 3310' to 3230'
Crushed rock from 3230' to 3115'
4 sacks reg. cement from 3115' to 3092'
Fill hole w/mud from 3092' to 270'
Set crushed rock bridge & 15 sks cement
270' to 230'
Filled with mud from 230' to 30'
Dump 10 sks. reg. cement from 30' to Base of cellar.

RECEIVED
STATE CORPORATION COMMISSION
FEB 15 1951
CONSERVATION DIVISION
Wichita, Kansas

2-15-51

(If additional description is necessary, use BACK of this sheet)

Correspondence regarding this well should be addressed to The Carter Oil Company
Address Box 786, Great Bend, Kansas

STATE OF Kansas, COUNTY OF Barton, ss.

W. D. Maxwell (employee of owner) or (owner or operator) of the above-described well, being first duly sworn on oath, says: That I have knowledge of the facts, statements, and matters herein contained and the log of the above-described well as filed and that the same are true and correct. So help me God.

(Signature) W. D. Maxwell
Box 786, Great Bend, Kansas
(Address)

SUBSCRIBED AND SWORN to before me this 12 day of Feb, 1951

My commission expires My Commission Expires July 29, 1954

22-5133-s 9-48-10M

PLUGGING
FILE SEC 2 T 3 R 19W
BOOK PAGE 59 LINE 4W

Notary Public



15-147-00886-00-00 1

THE CARTER OIL COMPANY

TULSA 2, OKLAHOMA

DATE Feb 8, 1951

NAME

SHOW THIS NUMBER ON INVOICE

No. A-427-B

State Corporation Commission
Conservation Division
800 Bitting Building
Wichita, Kansas

RENDER ONLY ONE INVOICE
IN DUPLICATE FOR EACH ORDER
AND MAIL TO:

THE CARTER OIL CO.
BOX 801, TULSA 2, OKLA.

SHIP TO - THE CARTER OIL COMPANY
AT Box 786 Great Bend, Kan

THIS ORDER ACCEPTED BY VENDOR SUBJECT
TO INSTRUCTIONS AND CONDITIONS ON REVERSE
SIDE.

CARE OF W. D. Maxwell

F. O. B.

QUANTITY	DESCRIPTION OF MATERIAL OR OTHER SERVICE	PRICE
	<p>CHARGE: APR 1299 F. H. Eltiste #1 - Aband</p> <p>Invoice dtd 2-5-51</p> <p>For services rendered to plug and abandon above well in C SE NE 2-3-19W, Phillips County, Kansas</p> <p>CONTRACT PRICE</p> <p>File No. 59-42</p> <div style="text-align: center;"> <p>RECEIVED</p> <p>STATE CORPORATION COMMISSION</p> <p>FEB 13 1951 2-13-51</p> <p>CONSERVATION DIVISION</p> <p>Wichita, Kansas</p> <p>PLUGGING</p> <p>2-3-19W</p> <p>59-42</p> </div>	<p>25.00</p>

MAIL ALL CORRESPONDENCE
ON THIS ORDER TO

THE CARTER OIL COMPANY
MATERIAL AND TRAFFIC DEPARTMENT
L. E. PATTEN
TULSA 2, OKLAHOMA

MATERIAL AND/OR SERVICES RECEIVED
W. H. Kinsley
REPRESENTATIVE

15-147-00886-00-00

For State

The Carter Oil Company
F. H. ELLISTE #1
SW NW of 1 & S/2 NE OF SEC. 2-3s-19w
Phillips County, Kansas

DRILLER'S LOG

Sand and Clay	0	25'
Shale and Shells	25'	285'
Shale	285'	406'
Shale and Shells	406'	690'
Sand and Shale Streaks	690'	924'
Sand and Shale	924'	1225'
Shale and Shells	1225'	1424'
Shale and Shells	1424'	1516'
Anhydrite	1516'	1534'
Anhydrite	1534'	1545'
Shale and Lime Streaks	1545'	1750'
Shale and Lime Streaks	1750'	1915'
Shale and Lime Streaks	1915'	1935'
Shale and Lime	1935'	1990'
Red Rock and Shale Streaks	1990'	2032'
Shale and Lime	2032'	2043'
Shale and Lime	2043'	2150'
Shale and Lime	2150'	2279'
Shale and Lime	2279'	2368'
Shale and Lime	2368'	2432'
Shale and Lime	2432'	2488'
Shale and Lime	2488'	2554'
Shale and Lime Streaks	2554'	2646'
Shale and Lime	2646'	2690'
Shale	2690'	2737'
Lime	2737'	2752'
Lime	2752'	2812'
Shale and Lime	2812'	2827'
Shale and Lime	2827'	2866'
Broken Lime	2866'	2893'
Broken Lime	2892'	2954'
Cherty	2954'	2957'
Lime	2957'	3018'
Shale	3018'	3025'
Lime	3025'	3048'
Lime	3048'	3096'
Lime	3096'	3113'
Lime	3113'	3169'
Chert	3169'	3171'
Broken Lime	3171'	3193'
Broken Lime	3193'	3207'
Lime	3207'	3244'
Lime	3244'	3297'
Lime	3297'	3310'

Geological Tops

Stone Corral Anhydrite . . . 1516'
Topeka 2892'
Kansas City 3120'

Production

349 bbl.

Total Depth

3310'

Date Commenced

6-21-42

Date Completed

7-24-42

Total Depth 3310'

PLUGGING
FILE SEC 2 T 2 R (19)
BOOK PAGE 59 LINE 42

RECEIVED
STATE CORPORATION COMMISSION
FEB 15 1951
CONSERVATION DIVISION
Wichita, Kansas
2-15-51