

13-147-00885-00-00

STATE OF KANSAS
STATE CORPORATION COMMISSION

WELL PLUGGING RECORD

Give All Information Completely
Make Required Affidavit
Mail or Deliver Report to:
Conservation Division
State Corporation Commission
800 Biting Building
Wichita, Kansas

OR

FORMATION PLUGGING RECORD

Strike out upper line
when reporting plugging
off formations.

Phillips

County. Sec. 1 Twp. 3 Rge. (E) 19 (W)

Location as "NE $\frac{1}{4}$ NW $\frac{1}{4}$ SW $\frac{1}{4}$ " or footage from lines. NW $\frac{1}{4}$ NW $\frac{1}{4}$

Lease Owner. W. A. RAGLIN

Lease Name. Lizzie Grote Well No. 2

Office Address. Great Bend Kansas

Character of Well (completed as Oil, Gas or Dry Hole). Oil

Date well completed. 1942

Application for plugging filed. 19

Application for plugging approved. 19

Plugging commenced. July 24 1946


Plugging completed. July 29 1946

Reason for abandonment of well or producing formation. Production down

to 2 Bbls daily

If a producing well is abandoned, date of last production. 6-1-46 19

Was permission obtained from the Conservation Division or its agents before plugging was commenced? Yes

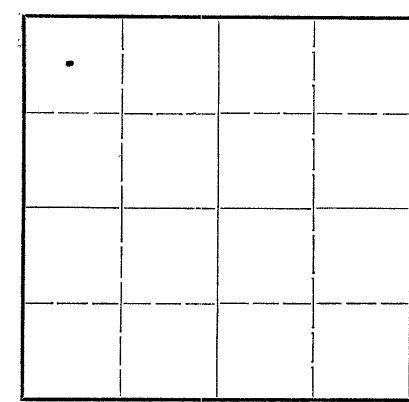

Locate well correctly on above
Section Plat

Name of Conservation Agent who supervised plugging of this well. H. W. Kerr

Producing formation. Kansas City Depth to top. 3140 Bottom. 3355 Total Depth of Well. 3355 Feet

Show depth and thickness of all water, oil and gas formations.

OIL, GAS OR WATER RECORDS


CASING RECORD

Formation	Content	From	To	Size	Put In	Pulled Out
				8 5/8	289'	0
				5 1/2	3355	2531'

Describe in detail the manner in which the well was plugged, indicating where the mud fluid was placed and the method or methods used in introducing it into the hole. If cement or other plugs were used, state the character of same and depth placed, from _____ feet to _____ feet for each plug set.

Filled with mud to 3160' ran 5 sack cement
" " " " 200' " 15"
" " " " 25' " 10"

Rd.
9/9/46
na,
1

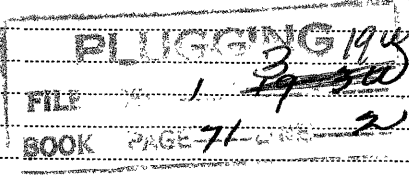


(If additional description is necessary, use BACK of this sheet)

Correspondence regarding this well should be addressed to. W. A. RAGLIN
Address. Box 245 Great Bend Kansas

STATE OF Kansas, COUNTY OF Barton, ss.
W. A. Raglin

(employee of owner) or (owner or operator) of the above-described well,
being first duly sworn on oath, says: That I have knowledge of the facts, statements, and matters herein contained and the log of the above-described well as filed and that the same are true and correct. So help me God.

(Signature) W. A. Raglin

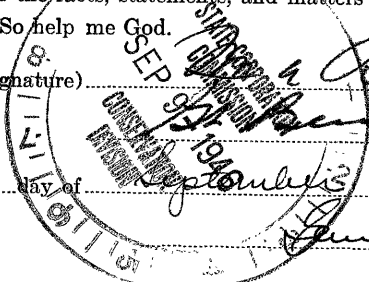

SUBSCRIBED AND SWORN TO before me this 6th day of September, 1946

My commission expires April 10, 1950

9-9-46