


STATE OF KANSAS
STATE CORPORATION COMMISSION

WELL PLUGGING RECORD

Give All Information Completely
Make Required Affidavit
Mail or Deliver Report to
Conservation Division
State Corporation Comm.
245 North Water
Wichita, KS 67202

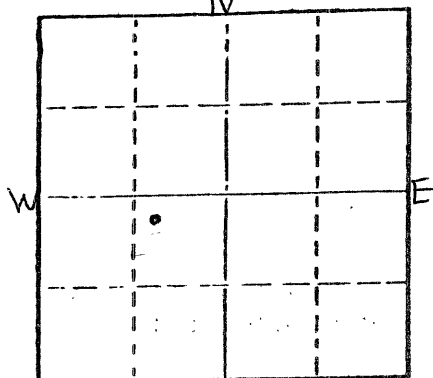

Locate well correctly on above
Section Plot

Phillips County. Sec. 23 Twp. 3S Rge. 19 E/W
Location as "NE/CNW $\frac{1}{4}$ SW $\frac{1}{4}$ " or footage from lines

C NW NE SW
Lease Owner Lowell Keesee
Lease Name EHM -(Keesee) Well No. 1
Office Address 797 3rd Street, Phillipsburg, Ks. 67661
Character of Well (Completed as Oil, Gas or Dry Hole)

Dry Hole
Date Well completed October 6 1976
Application for plugging filed (Verbally) October 6 1976
Application for plugging approved (Verbally) October 6 1976
Plugging commenced October 6 1976
Plugging completed October 6 1976

Reason for abandonment of well or producing formation
No commercial quantity of oil or gas encountered
If a producing well is abandoned, date of last production 19

Was permission obtained from the Conservation Division or
its agents before plugging was commenced? Yes

Name of Conservation Agent who supervised plugging of this well Leo Massey
Producing formation Depth to top Bottom Total Depth of Well
Show depth and thickness of all water, oil and gas formations.

OIL, GAS OR WATER RECORDS

CASING RECORD

| FORMATION | CONTENT | FROM | TO | SIZE | PUT IN | PULLED OUT |
|-----------|---------|------|----|------|--------|------------|
| | | | | | | |
| | | | | | | |
| | | | | | | |
| | | | | | | |

Describe in detail the manner in which the well was plugged, indicating where the mud fluid was placed and the method or methods used in introducing it into the hold. If cement or other plugs were used, state the character of same and depth placed, from feet to feet for each plug set.

Set 1st plug at 900' with 70 sx.

2nd plug at 185' with 20 sx.,

3rd plug at 40' with 10 sx.

State plugger - Leo Massey

Plug was down at 1:30 p.m. 10-6-76.

RECEIVED
STATE CORPORATION COMMISSION

OCT 13 1976

CONSERVATION DIVISION
Wichita, Kansas

10-13-76

(If additional description is necessary, use BACK of this sheet)

Name of Plugging Contractor Abercrombie Drilling, Inc.

STATE OF Kansas COUNTY OF Sedgwick ss.

Jack L. Partridge, Asst. Sec.-Treas. (employee of owner) or (owner or operator) of the above-described

well, being first duly sworn on oath, says: That I have knowledge of the facts, statements, and matters herein contained and the log of the above-described well as filed and that the same are true and correct. So help me God.

(Signature)

801 Union Center, Wichita, Kansas 67202

(Address)

SUBSCRIBED AND SWORN TO before me this 11th day of October 1976

My commission expires

Kathy S. Goertz
Kathy S. Goertz

Notary Public.

