


15-147-00101-00-00

STATE OF KANSAS  
STATE CORPORATION COMMISSION

WELL PLUGGING RECORD

Give All Information Completely  
Make Required Affidavit  
Mail or Deliver Report to:  
Conservation Division  
State Corporation Commission  
800 Bitting Building  
Wichita, Kansas

NORTH

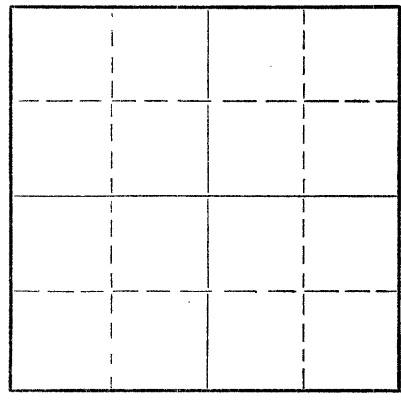

Locate well correctly on above  
Section Plat

Phillips County. Sec. 14 Twp. 3 Rge. 19W (E) (W)  
Location as "NE/CNW/SW" or footage from lines SE SE NE  
Lease Owner Imperial Petroleum Company, Inc.  
Lease Name Vogel Well No. 1  
Office Address 903 Union National Bank Bldg., Wichita, Ks.  
Character of Well (completed as Oil, Gas or Dry Hole) Oil Well  
Date well completed November 29 19 50  
Application for plugging filed December 18 19 52  
Application for plugging approved December 22 19 52  
Plugging commenced January 7 19 53  
Plugging completed January 10 19 53  
Reason for abandonment of well or producing formation unable to produce oil  
in commercial quantities  
If a producing well is abandoned, date of last production December 15 19 52  
Was permission obtained from the Conservation Division or its agents before plugging was commenced? yes

Name of Conservation Agent who supervised plugging of this well Eldon Petty  
Producing formation Lansing Kansas City Depth to top 3128 Bottom 3150 Total Depth of Well 3150 Feet  
Show depth and thickness of all water, oil and gas formations.

OIL, GAS OR WATER RECORDS

CASING RECORD

FORMATION	CONTENT	FROM	TO	SIZE	PUT IN	PULLED OUT
				5 1/2"	3146'	2597'
				8 5/8"	168'	none

Describe in detail the manner in which the well was plugged, indicating where the mud fluid was placed and the method or methods used in introducing it into the hole. If cement or other plugs were used, state the character of same and depth placed, from \_\_\_\_\_ feet to \_\_\_\_\_ feet for each plug set.

Sanded hole from 3151' to 3130' and ran 4 sacks of cement. Mudded hole to 168', set rock bridge to 155' and ran 15 sacks of cement. Mudded hole to 35' set rock bridge to 27' and ran 10 sacks of cement. Plugging completed.

RECEIVED  
FEB 11 1953  
2-4-53

(If additional description is necessary, use BACK of this sheet)

Name of Plugging Contractor West Supply Company  
Address Chase, Kansas

STATE OF KANSAS, COUNTY OF SEDGWICK, ss.  
Raymond L. Bacon (employee of owner) or (owner or operator) of the above-described well, being first duly sworn on oath, says: That I have knowledge of the facts, statements, and matters herein contained and the log of the above-described well as filed and that the same are true and correct. So help me God. IMPERIAL DRILLING COMPANY, INC.

(Signature) By Raymond L. Bacon Vice-President  
903 Union National Bank Bldg.,  
Wichita, Kansas (Address)

SUBSCRIBED AND SWORN to before me this 2nd day of February, 19 53

My commission expires January 4, 1954  
Marquitta Little Notary Public.

24-2675-S 2-52-20M

PLUGGING  
FILE SEC 14-3-R-19W  
BOOK PAGE 67 LINE 3

IMPERIAL PETROLEUM COMPANY, INC.  
VOGEL # 1

SE SE NE Sec. 14-3S-19W  
Phillips County, Kansas

Total Depth: 3150'  
Comm: 11-21-50  
Comp: 11-29-50

<u>Casing</u>	<u>Cement</u>
8 5/8" set @ 168'	115 sacks
5 1/2" set @ 3146'	75 sacks

<u>Formation</u>	<u>Depth</u>
Surface Soil & sand	0 - 60
Shale & shells	60 - 135
Shale	135 - 625
Sand	625 - 745
Shale	745 - 1015
Sand	1015 - 1200
Shale	1200 - 1428
Red bed & shells	1428 - 1500
Anhydrite	1500 - 1530
Shale & shells	1530 - 2010
Shale & lime	2010 - 2993
Sandy lime	2993 - 3020
Lime & shale	3020 - 3070
Lime	3070 - 3120
Lime & shale	3120 - 3150

STATE OF KANSAS }  
SEDGWICK COUNTY } SS

RECEIVED  
FEB 16 1953  
DIVISION

2-4-53

We hereby certify that the above information is true and correct to the best of my knowledge.

IMPERIAL DRILLING COMPANY, INC.

By: Raymond J. Bacon  
Vice-Pres.

Subscribed and sworn to before me this 16th day of January, 1953.

Maguette Tuttle  
Notary Public

My commission expires:  
1-4-54

**PLUGGING**

FILE 14-3-19W  
BOOK PAGE 67 LINE 3