


STATE OF KANSAS  
STATE CORPORATION COMMISSION

Give All Information Completely  
Make Required Affidavit  
Mail or Deliver Report to:  
Conservation Division  
State Corporation Commission  
800 Bitting Building  
Wichita, Kansas

15-147-00107-00-00

WELL PLUGGING RECORD

NORTH

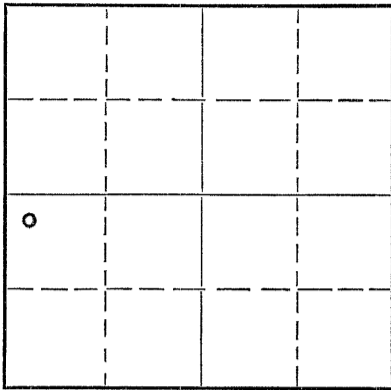

Locate well correctly on above  
Section Plat

Phillips County. Sec. 32 Twp. 3S Rge. 19W (E) West (W)  
Location as "NE/CNW $\frac{1}{4}$ SW $\frac{1}{4}$ " or footage from lines NW NW SW  
Lease Owner National Associated Petroleum Company  
Lease Name George F. Pflieger Well No. 1  
Office Address 5th Floor Ritz Bldg. - Tulsa, Oklahoma  
Character of Well (completed as Oil, Gas or Dry Hole) Dry Hole  
Date well completed 5-17, 19 52  
Application for plugging filed 5-17, 19 52  
Application for plugging approved 5-17- 19 52  
Plugging commenced 2:00 p.m. 5-17, 19 52  
Plugging completed 3:00 p.m. 5-17, 19 52  
Reason for abandonment of well or producing formation Dry hole

If a producing well is abandoned, date of last production 19  
Was permission obtained from the Conservation Division or its agents before plugging was commenced? Yes

Name of Conservation Agent who supervised plugging of this well Eldon Petty  
Producing formation Depth to top Bottom Total Depth of Well 3657 Feet  
Show depth and thickness of all water, oil and gas formations.

OIL, GAS OR WATER RECORDS

CASING RECORD

Formation	Content	From	To	Size	Put In	Pulled Out
Topeka ls.	Water	3044	3162	8-5/8"	189'	None
Lansing-Kansas City	Water	3271	3498			
Arbuckle	Water	3592	3657			

Describe in detail the manner in which the well was plugged, indicating where the mud fluid was placed and the method or methods used in introducing it into the hole. If cement or other plugs were used, state the character of same and depth placed, from \_\_\_\_\_ feet to \_\_\_\_\_ feet for each plug set.

Halliburton plug set @ 175' with 1/2 sack of hulls, 15 sacks of reg. cement; filled w/mud with mud pump on rotary to 40'; set Halliburton plug @ 40' with 1/2 sack of hulls, 10 sx of cement; filled to top of surface casing.

RECEIVED  
STATE CORPORATION COMMISSION

MAY 2 1952

CONSERVATION DIVISION  
Wichita, Kansas

5-29-52

(If additional description is necessary, use BACK of this sheet)

Name of Plugging Contractor D & M Drilling Company  
Address Box 247 - Great Bend, Kansas

STATE OF Oklahoma, COUNTY OF Tulsa, ss.  
C. Edwin Mohler (employee of owner) or (owner or operator) of the above-described well,  
being first duly sworn on oath, says: That I have knowledge of the facts, statements, and matters herein contained and the log of the above-described well as filed and that the same are true and correct. So help me God.

(Signature) C. Edwin Mohler, Chief Geologist


5th Floor Ritz Bldg. - Tulsa, Oklahoma  
(Address)

SUBSCRIBED AND SWORN to before me this 28th day of May, 1952

Margie M. Davis  
Notary Public.

My commission expires Feb. 19, 1953

23-8390-s 6-51-20M

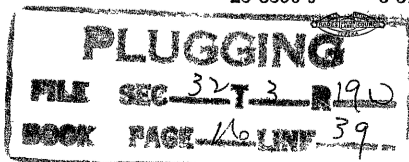

15-147-00107-00-00

NATIONAL ASSOCIATED PETROLEUM COMPANY

5th Floor Ritz Bldg. - Tulsa, Oklahoma

PFLEIGER # 1

NW/4 NW/4 SW/4 Section 32-38-19W Phillips County, Kansas

Rigging up Rotary Tools 5/4 /52 Run 6 Jts. 8-5/8" surface pipe. Set at  
Tearing down Rotary Tools 5/17/52 187' and cemented with 150 sx cement.

<u>FORMATION</u>	<u>FROM</u>	<u>TO</u>	
Shale and Shells	0 feet	187 feet	
Gray Shale	187	300	
Gypsum	300	350	
Gray Shale	350	850	
Shale and Sand	850	950	
Shale and Shells	950	1600	
Anhydrite	1600	1660	
Shale and Shells	1660	2265	
Shale and Shells and Lime Streaks	2265	2450	
Lime and Shale	2450	2695	
Shale and Lime Streaks	2695	2930	
Lime and Shale	2930	3175	
Lime	3175	3211	
Lime and Shale Streaks	3211	3325	
Cherty Lime and Shale	3325	3358	
Lime and Shale Streaks	3358	3410	
Lime	3410	3470	3410
Lime and Shale	3470	3495	
Lime and Chert Streaks	3495	3550	
Shale and Lime Streaks	3550	3600	
Lime	3600	3620	
Lime and Chert	3620	3656	TOTAL DEPTH

I, Don S. Packer, hereby certify that the above log is true and correct, to the best of my knowledge and belief.

*Don S. Packer*

Subscribed and sworn to before me this 27 day of May, 1952.

*Warren H. Kopke*  
Notary Public

My Commission Expires 9-24-55

RECEIVED  
REGISTRATION COMMISSION  
JUN 2 - 1952  
6-2-52  
PLUGGING  
FILE SEC 32-38-19W  
BOOK PAGE 16 LINE 39  
REGISTRATION DIVISION  
WICHITA, KANSAS