

15-147-20253-00-00


STATE OF KANSAS  
STATE CORPORATION COMMISSION

WELL PLUGGING RECORD

Give All Information Completely  
Make Required Affidavit  
Mail or Deliver Report to  
Conservation Division  
State Corporation Comm.  
245 North Water  
Wichita, KS 67202

Phillips County. Sec. 26 Twp. 3 Rge. 19 E/W  
Location as "NE/CNW $\frac{1}{4}$ SW $\frac{1}{4}$ " or footage from lines  
NE NW SE

Lease Owner Thornton Anderson  
Lease Name Veeh #3 Well No. \_\_\_\_\_  
Office Address Wichita, Kansas 67202  
Character of Well (Completed as Oil, Gas or Dry Hole) \_\_\_\_\_

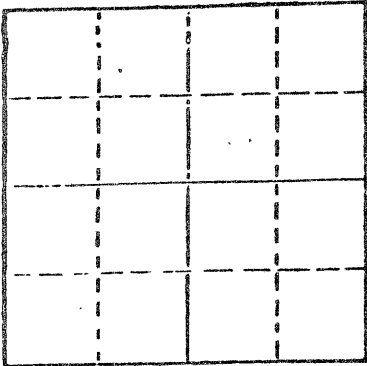

Locate well correctly on above  
Section Plat

Date Well completed \_\_\_\_\_ 19\_\_\_\_  
Application for plugging filed \_\_\_\_\_ 19\_\_\_\_  
Application for plugging approved \_\_\_\_\_ 19\_\_\_\_  
Plugging commenced 6/13/79 \_\_\_\_\_ 19\_\_\_\_  
Plugging completed 6/18/79 \_\_\_\_\_ 19\_\_\_\_  
Reason for abandonment of well or producing formation  
depleted

If a producing well is abandoned, date of last production  
\_\_\_\_\_ 19\_\_\_\_

Was permission obtained from the Conservation Division or  
its agents before plugging was commenced? yes

Name of Conservation Agent who supervised plugging of this well Schmidt  
Producing formation \_\_\_\_\_ Depth to top \_\_\_\_\_ Bottom \_\_\_\_\_ Total Depth of Well 3234  
Show depth and thickness of all water, oil and gas formations.

OIL, GAS OR WATER RECORDS

CASING RECORD

FORMATION	CONTENT	FROM	TO	SIZE	PUT IN	PULLED OUT
				8-5/8	289	none
				5 1/2"	3172	2561'

Describe in detail the manner in which the well was plugged, indicating where the mud fluid  
was placed and the method or methods used in introducing it into the hold. If cement or other  
plugs were used, state the character of same and depth placed, from \_\_\_\_\_ feet to  
\_\_\_\_\_ feet for each plug set.

Sanded to 3000', ran 5 sacks cement. Loaded hole with water, shot pipe at  
2868', 2745', 2542', pulled 70 joints. Pumped 145 sacks 50-50 pos, 6%,  
15 sacks gel and 2 sacks hulls.

RECEIVED  
STATE CORPORATION COMMISSION

PLUGGING COMPLETE.

JUN 25 1979

CONSERVATION DIVISION  
Wichita, Kansas

(If additional description is necessary, use BACK of this sheet)

Name of Plugging Contractor KESLO CASING PULLING  
CHASE, KANSAS


STATE OF KANSAS COUNTY OF RICE, ss.  
R. DARRELL KESLO (employee of owner) or (owner or operator)  
of the above-described well, being first duly sworn on oath, says: That I have knowledge of  
the facts, statements, and matters herein contained and the log of the above-described well  
as filed and that the same are true and correct. So help me God.

(Signature) R. Darrell Keslo  
CHASE, KANSAS (Address)

SUBSCRIBED AND SWORN TO before me this 20th day of June, 1979

Margaret Melaker  
Notary Public.

My commission expires

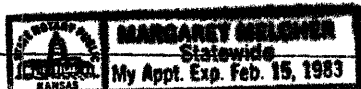

Well log

15-147-20253-00-00

CONTRACTOR'S WELL LOG

OPERATOR: Thornton E. Anderson  
 CONTRACTOR: Abercrombie Drilling, Inc.  
 WELL NAME: Veeh #2  
 LOCATION: NE NW SE, Section 26-3S-19W  
 Phillips County, Kansas  
 SPUD DATE: May 03, 1979  
 COMPLETION DATE: May 08, 1979

0	1507	Sand and shale
1507	1536	Anhydrite
1536	1730	Sand and shale
1730	2343	Shale
2343	2835	Shale and lime
2835	3174	Lime and shale
	3174	Rotary Total Depth

Spud hole at 6:45 p.m., May 03, 1979. Drilled 290' of 12 1/4" hole. Ran 7 joints of 8-5/8" - 28# steel casing. Set at 289' K.B. with 220 sacks of common cement, 3% Ca.Cl., 2% gel. Cement did circulate. Plug was down at 1:30 a.m., May 04, 1979.

T.D. 3174'. Ran 89 joints of 5 1/2" - 14# casing. Set at 3172' with 50 sacks of common cement, salt saturated. Plug was down at 4:15 p.m., May 08, 1979.

SAMPLE TOPS:

Anhydrite 1507'  
 B/Anhydrite 1536'

RECEIVED  
 STATE CORPORATION COMMISSION

JUN 25 1979

STATE OF KANSAS )  
 ) ss  
 COUNTY OF SEDGWICK )

CONSULTATION DIVISION  
 Wichita, Kansas


0-25-79

Jack L. Partridge, Assistant Secretary-Treasurer of Abercrombie Drilling, Inc., does hereby state that the above and foregoing is a true and correct copy of the log of the Veeh #2, NE NW SE, Section 26-3S-19W, Phillips County, Kansas.

ABERCROMBIE DRILLING, INC.

BY Jack L. Partridge  
 Jack L. Partridge  
 Assistant Secretary-Treasurer

Subscribed and sworn to before me, a Notary Public, in and for the county and state aforesaid, as of this 15th day of May, 1979.

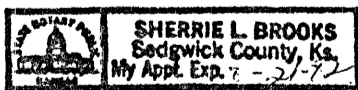

Sherrie L. Brooks  
 Sherrie Brooks, Notary Public

My commission expires 8-21-82.