

15-147-20244-0000


STATE OF KANSAS
STATE CORPORATION COMMISSION

WELL PLUGGING RECORD

Give All Information Completely
Make Required Affidavit
Mail or Deliver Report to
Conservation Division
State Corporation Comm.
245 North Water
Wichita, KS 67202

Phillips County. Sec. 26 Twp. 3S Rge. 19 N/W
Location as "NE/CNW 1/4 SW 1/4" or footage from lines
100' N of NW SE SE

Lease Owner Petroleum Management Inc., (PMI)
Lease Name Veeh Well No. #2
Office Address Box 56 Plainville, Kansas 67663
Character of Well (Completed as Oil, Gas or Dry Hole)

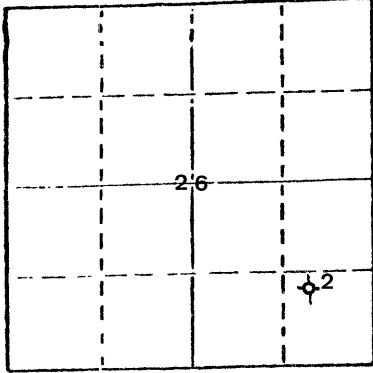

Locate well correctly on above
Section Plot

Dry Hole
Date Well completed October 3, 1978
Application for plugging filed October 3, 1978
Application for plugging approved October 3, 1978
Plugging commenced September 26, 1978
Plugging completed October 3, 1978
Reason for abandonment of well or producing formation
No Commercial Production

If a producing well is abandoned, date of last production
19

Was permission obtained from the Conservation Division or
its agents before plugging was commenced? yes

Name of Conservation Agent who supervised plugging of this well Leo Massey
Producing formation _____ Depth to top _____ Bottom _____ Total Depth of Well 3418'
Show depth and thickness of all water, oil and gas formations.

OIL, GAS OR WATER RECORDS

CASING RECORD

FORMATION	CONTENT	FROM	TO	SIZE	PUT IN	PULLED OUT
Surface Casing		0	197'	8 5/8"	197'	0

Describe in detail the manner in which the well was plugged, indicating where the mud fluid
was placed and the method or methods used in introducing it into the hold. If cement or other
plugs were used, state the character of same and depth placed, from _____ feet to
_____ feet for each plug set.

900' with 70 sxs
185' with 20 sxs
40' with 15 sxs Hulls and 10 sxs cement 50-50 poz 6% gel

RECEIVED
STATE CORPORATION COMMISSION

OCT 13 1978

Wichita, Kansas

10-13-78

(If additional description is necessary, use BACK of this sheet)

Name of Plugging Contractor Pioneer Drilling Co., Inc., 308 West Mill, Plainville, Ks. 67663

STATE OF Kansas COUNTY OF Sedgwick, ss.
Dale Silcott (employee of owner) or (owner or operator)

of the above-described well, being first duly sworn on oath, says: That I have knowledge of
the facts, statements, and matters herein contained and the log of the above-described well
as filed and that the same are true and correct. So help me God.

(Signature)

Dale Silcott
400 N. Woodlawn, Suite 201, Wichita, Ks.
(Address) 67208

SUBSCRIBED AND SWORN TO before me this 11th day of October, 1978

My commission expires



Bonnie Brown - Notary Public.