


Give All Information Completely
Make Required Affidavit
Mail or Deliver Report to:
Conservation Division
State Corporation Commission
800 Bitting Building
Wichita, Kansas

OR
FORMATION PLUGGING RECORD

Strike out upper line
when reporting plug-
ging off formations.

Phillips County. Sec. 26 Twp. 3S Rge. 19 (W)
Location as "NE $\frac{1}{4}$ NW $\frac{1}{4}$ SW $\frac{1}{4}$ " or footage from lines SW NW NW
Lease Owner Bridgeport Oil Company, Inc.,
Lease Name Grau "A"
Office Address 918 Central Building - Wichita 2, Kansas
Character of Well (completed as Oil, Gas or Dry Hole) Dry Hole
Date well completed 1 - 9 - 19.45
Application for plugging filed 1 - 9 - 19.45
Application for plugging approved 1 - 9 - 19.45
Plugging commenced 1 - 9 - 19.45
Plugging completed 1 - 9 - 19.45
Reason for abandonment of well or producing formation Dry Hole

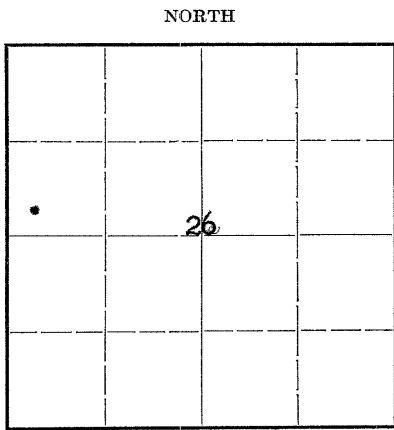

Locate well correctly on above
Section Plat

If a producing well is abandoned, date of last production 19...
Was permission obtained from the Conservation Division or its agents before plugging was com-
menced? Yes

Name of Conservation Agent who supervised plugging of this well H. W. Kerr - Great Bend, Kansas
Producing formation Depth to top Bottom Total Depth of Well 3635 Feet
Show depth and thickness of all water, oil and gas formations.

OIL, GAS OR WATER RECORDS

CASING RECORD

Formation	Content	From	To	Size	Put In	Pulled Out
				8 5/8"	211'	None


Describe in detail the manner in which the well was plugged, indicating where the mud fluid was placed and the method or methods used in introducing it into the hold. If cement or other plugs were used, state the character of same and depth placed, from feet to feet for each plug set.

Filled hole with mud 3635' to 210'

Set plug at 210' with 15 sacks

Filled hole with mud to 15'

Set plug at 15' and cemented on top of plug with 10 sacks to within 6' of top

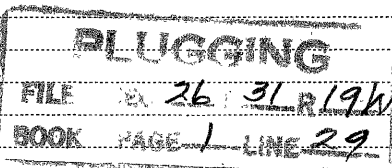

(If additional description is necessary, use BACK of this sheet)

Correspondence regarding this well should be addressed to Bridgeport Oil Company, Inc.,
Address 918 Central Building - Wichita 2, Kansas.

STATE OF Kansas, COUNTY OF Sedgwick, ss.
Frank Leach (employee of owner) or (owner or operator) of the above-described well,
being first duly sworn on oath, says: That I have knowledge of the facts, statements, and matters herein contained and the log of the above-described well as filed and that the same are true and correct. So help me God.

(Signature)

Frank Leach


Wichita, Kansas

(Address)

SUBSCRIBED AND SWORN TO before me this 12th day of January

My commission expires Oct. 29, 1947

My commission expires

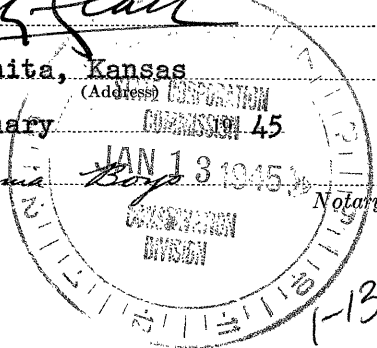

Notary Public.

1-13-45