


Give All Information Completely
Make Required Affidavit
Mail or Deliver Report to:
Conservation Division
State Corporation Commission
800 Bittling Building
Wichita, Kansas

15-147-00072-00-00

WELL PLUGGING RECORD

NORTH

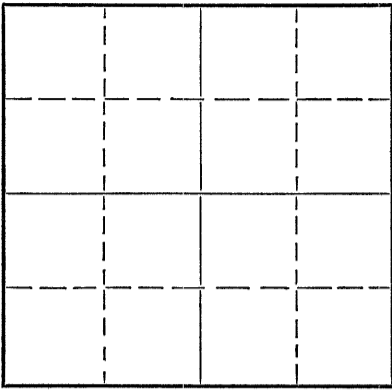

Locate well correctly on above
Section Plat

Phillips County. Sec. 24 Twp. 3 Rge. (E) 19 (W)
Location as "NE/CNW $\frac{1}{4}$ SW $\frac{1}{4}$ " or footage from lines NW NW NW
Lease Owner Westgate-Greenland Oil Company
Lease Name Dieckhoff Well No. 1
Office Address 1009 Central Building, Wichita 2, Kansas
Character of Well (completed as Oil, Gas or Dry Hole) dry hole
Date well completed February 10, 1951 19
Application for plugging filed February 14, 1951 19
Application for plugging approved February 15, 1951 19
Plugging commenced March 30, 1951 19
Plugging completed March 24, 1951 19
Reason for abandonment of well or producing formation _____

If a producing well is abandoned, date of last production _____ 19
Was permission obtained from the Conservation Division or its agents before plugging was commenced? yes

Name of Conservation Agent who supervised plugging of this well Elden Petty
Producing formation _____ Depth to top _____ Bottom _____ Total Depth of Well _____ Feet
Show depth and thickness of all water, oil and gas formations.

OIL, GAS OR WATER RECORDS

CASING RECORD

Formation	Content	From	To	Size	Put In	Pulled Out
Surface		0	194	8 5/8"	194	none
Lansing		0	3238	5 1/2"	3238	2652.55'

Describe in detail the manner in which the well was plugged, indicating where the mud fluid was placed and the method or methods used in introducing it into the hole. If cement or other plugs were used, state the character of same and depth placed, from _____ feet to _____ feet for each plug set.

Filled with sand from total depth to 3210 feet
Ran 4 sacks cement from 3210 to 3185 feet
Filled with heavy mud from 3185 feet to 190 feet
Ran 15 sacks cement from 190 to 150 feet
Filled with heavy mud from 150 feet to 30 feet
Ran 10 sacks cement from 30 feet to cellar.

(If additional description is necessary, use BACK of this sheet)

Correspondence regarding this well should be addressed to Westgate-Greenland Oil Company
Address 1009 Central Building, Wichita 2, Kansas

STATE OF Kansas, COUNTY OF Sedgwick, ss.
G. E. Bitler (employee of owner) or ~~(conservation operator)~~ of the above-described well,
being first duly sworn on oath, says: That I have knowledge of the facts, statements, and matters herein contained and the log of the above-described well as filed and that the same are true and correct. So help me God.

(Signature) G. E. Bitler
1009 Central Building, Wichita 2, Kansas
(Address)

SUBSCRIBED AND SWORN to before me this 4th day of April, 1951

My commission expires May 25, 1953. Esther Truitt Notary Public.

28-5091-s 8-50-10M

RECEIVED
STATE CORPORATION COMMISSION
APR - 4 1951 4-4-51
PLUGGING
FILE SEC 24 T 3 R 99 NS
BOOK PAGE 61 LINE 41
CONSERVATION DIVISION
Wichita, Kansas

15-147-00072-00-00

COMPANY: Westgate Greenland Oil Co.
 CONTRACTOR: Jackson Drilling Corporation
 FARM: Dieckhoff #1
 LOCATION: NW NW NW Section 24-3-19W,
 Phillips County, Kansas
 ELEVATION: 1959
 COMMENCED: January 16, 1951
 COMPLETED: January 24, 1951 - Rotary
 February 10, 1951 - Cardwell

0 to 10	Soil and Clay
10 to 240	Shale
240 to 290	Shale and Shells
290 to 400	Blue Shale
400 to 530	Sandy Shale
530 to 670	Shale and Shells
670 to 700	Sand
700 to 725	Shale and Shells
725 to 800	Sand
800 to 820	Shale, Shells and Sand
820 to 827	Hard Sand
827 to 1133	Shale w/Sand
1133 to 1215	Sand
1215 to 1510	Shale and Redbed
1510 to 1545	Anhydrite
1545 to 2075	Shale and Shells
2075 to 2095	Shale
2095 to 2230	Lime
2230 to 3109	Shale and Lime
3109 to 3243	T.D. Rotary
3243 to 3261	T.D. Cardwell

8 5/8" 24# casing set at 194 feet. Cemented with 140 sacks cement and 2 sacks calcium chloride.
 5 1/2" casing set at 3238 feet. Cemented with 75 sacks cement.
 Drill stem test 3233-3241. Open 30 minutes - recovered 50 feet of oil cut mud.
 1000 gallons Dowell Service. No show - Dowell water survey - 1000 gallons Dowell Service additional.
 Lane-Wells perforated 24 holes from 3228-3220. Set Lane-Wells bridging plug 3232.
 Tops: Anhydrite 1510
 Heebner 3117
 Lansing 3145

Dry
 All measurements from top of derrick floor.

C E R T I F I C A T E

I, Clare A. Stewart, do hereby certify that the above and foregoing is a true and correct copy of log of Dieckhoff #1, Section 24-3-19W, Phillips County, Kansas, as reflected by the files of the Jackson Drilling Corporation.

PLUGGING
 FILE SEC 24-3-19W
 BOOK PAGE 61 LINE 41

Clare A. Stewart
 Clare A. Stewart

Subscribed and sworn to before me, a Notary Public, within and for Johnson County, Kansas, this 23rd day of March, 1951.

APR - 4 1951

Dorothy J. Wilson
 Dorothy J. Wilson

My Commission Expires November 30, 1951

CONSERVATION DIVISION
 Wichita, Kansas

4-4-51