


Give All Information Completely
Make Required Affidavit
Mail or Deliver Report to:
Conservation Division
State Corporation Commission
800 Bitting Building
Wichita, Kansas

15-147-00 117-00-00

WELL PLUGGING RECORD

NORTH

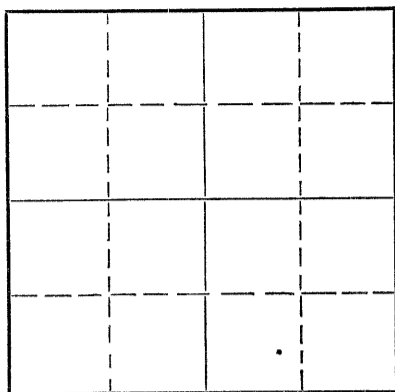

Locate well correctly on above
Section Plat

Phillips County. Sec. 36 Twp. 3S Rge. XXX 19 (W)
Location as "NE/CNW%SW%" or footage from lines SE/4 NE/4 SE/4
Lease Owner Sohio Petroleum Company
Lease Name Beckmann Well No. 1
Office Address P. O. Box 673, Russell, Kansas
Character of Well (completed as Oil, Gas or Dry Hole) Dry hole
Date well completed June 18, 1954
Application for plugging filed June 18, 1954
Application for plugging approved June 21, 1954
Plugging commenced June 18, 1954
Plugging completed June 18, 1954
Reason for abandonment of well or producing formation Dry hole
If a producing well is abandoned, date of last production _____ 19____
Was permission obtained from the Conservation Division or its agents before plugging was commenced? Yes

Name of Conservation Agent who supervised plugging of this well Eldon Petty
Producing formation _____ Depth to top _____ Bottom _____ Total Depth of Well 3632 Feet
Show depth and thickness of all water, oil and gas formations.

OIL, GAS OR WATER RECORDS

CASING RECORD

FORMATION	CONTENT	FROM	TO	SIZE	PUT IN	PULLED OUT
				8-5/8"	308'	None

Describe in detail the manner in which the well was plugged, indicating where the mud fluid was placed and the method or methods used in introducing it into the hole. If cement or other plugs were used, state the character of same and depth placed, from _____ feet to _____ feet for each plug set.

Filled hole with heavy mud from 3632' to 300'.
Set Halliburton plug at 300'.
Wrapped with two empty fiver sax.
Dumped 15 sax cement with drill pipe.
Mudded to 40'.
Dumped 1/2 sack hulls.
Set Halliburton plug & dumped 9 sax down casing.
Mudded to surface & dumped 1 sack cement on top of casing.
Well plugged & abandoned 6-18-54.

RECEIVED
STATE CORPORATION COMMISSION
JUN 25 1954
CONSERVATION DIVISION
Wichita, Kansas

(If additional description is necessary, use BACK of this sheet)
Name of Plugging Contractor Bill Hay Drilling Company 6-25-54
Address Hoisington, Kansas

STATE OF KANSAS, COUNTY OF RUSSELL, ss.
J. H. BOND (employee of owner) (owner of operator) of the above-described well, being first duly sworn on oath, says: That I have knowledge of the facts, statements, and matters herein contained and the log of the above-described well as filed and that the same are true and correct. So help me God.

(Signature) J. H. Bond
P.O. Box 673, Russell, Kansas
(Address)

SUBSCRIBED AND SWORN TO before me this 24 day of June, 1954
My Commission Expires July 2, 1957
Russell M Miller
Notary Public.

My commission expires _____
24-7368-S 3-53-20M

PLUGGING
FILE SEC 36 T 3 A 19W
BOOK PAGE 42 LINE 1

15-147-00117-00-00

Well Log

Beckmann #1
0-SE NE SE 36-35-19W
Phillips County, Kansas

0 - 75	Surface Clay and Sand
75 - 309	Shale and Sand
309 - 315	Shale
315 - 920	Shale, Sand and Iron
920 - 1465	Sand and Pyrite
1465 - 1555	Shale and Sand
1555 - 1585	Anhydrite
1585 - 1825	Shale and Shells
1825 - 1840	Sand Hard
1840 - 2800	Lime and Shale
2800 - 2990	Shale, Streaks Lime, Red Bed
2990 - 3151	Lime
3151 - 3223	Lime and Shale
3223 - 3305	Lime
3305 - 3414	Lime and Shale
3414 - 3425	Shale
3425 - 3631	Shale and Lime

State of Kansas
County of Barton

Jean Kimber, employee of Bill Hay Drilling Company, Drilling Contractor, being first duly sworn on oath, says: That I have knowledge of the facts, statements, and matters herein contained and the log of the above described well as filed and that the same are true and correct.

Jean Kimber
Box 194, Great Bend, Kansas

Subscribed and sworn to before me this 21st day of June, 1954.

Vergil C. Beckloff

My Commission Expires April 27, 1957.

PLUGGING
FILE SEC 36 3 R 19W
PAGE 42 LINE 1

9-21-54