

15-147-00009-00-00

STATE OF KANSAS
STATE CORPORATION COMMISSION


WELL PLUGGING RECORD

Give All Information Completely
Make Required Affidavit
Mail or Deliver Report to:
Conservation Division
State Corporation Commission
800 Bitting Building
Wichita, Kansas

OR
FORMATION PLUGGING RECORD

Strike out upper line
when reporting plug-
ging off formations.

NORTH

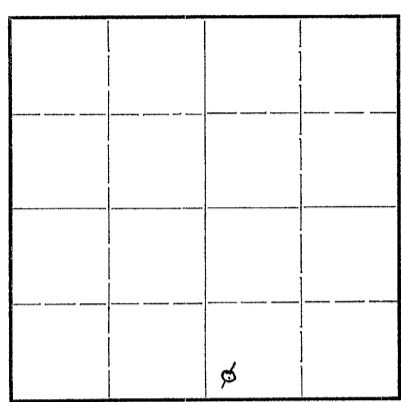

Locate well correctly on above
Section Plat

Phillips County. Sec. 36 Twp. 3 Rge. 19 (E) W (W)
Location as "NE 1/4 NW 1/4 SW 1/4" or footage from lines. SW SE

Lease Owner Derby Oil Co.
Lease Name Derby Oil #1 Beckman Well No. 1

Office Address 358 N. Broadway, Wichita 2, Kansas

Character of Well (completed as Oil, Gas or Dry Hole) Dry & Abandoned

Date well completed October 9 1944
Application for plugging filed October 9 1944
Application for plugging approved October 9 1944
Plugging commenced October 10 1944
Plugging completed October 10 1944

Reason for abandonment of well or producing formation
No commercial oil showings

If a producing well is abandoned, date of last production 19

Was permission obtained from the Conservation Division or its agents before plugging was com-
menced? Yes

Name of Conservation Agent who supervised plugging of this well Pop Kerr, Great Bend, Kansas

Producing formation Depth to top Bottom Total Depth of Well 3670 Feet

Show depth and thickness of all water, oil and gas formations.

OIL, GAS OR WATER RECORDS

CASING RECORD

Formation	Content	From	To	Size	Put In	Pulled Out
				8-5/8"	158'	None

Describe in detail the manner in which the well was plugged, indicating where the mud fluid was placed and the method or methods used in introducing it into the hold. If cement or other plugs were used, state the character of same and depth placed, from feet to feet for each plug set.

3670' to 161' - heavy mud
161' to 160' - wood
160' to 115' - 15 sx cement
115' to 40' - Mud
40' to 5' - 10 sx cement

FILE
BOOK
363
1944
134-43

(If additional description is necessary, use BACK of this sheet)

Correspondence regarding this well should be addressed to Derby Oil Company
Address 358 North Broadway, Wichita 2, Kansas

STATE OF KANSAS, COUNTY OF SEDGWICK, ss.
Thos. H. Allan, Contractor (employee of owner) or (owner or operator)

being first duly sworn on oath, says: That I have knowledge of the facts, statements, and matters herein contained and the log of the above-described well as filed and that the same are true and correct. So help me God.

(Signature) Thos. H. Allan
921 Union National Bank Bldg., Wichita 2, Kansas
(Address)

SUBSCRIBED AND SWORN TO before me this 13th day of October 1944

My commission expires May 12, 1948

OCT 16 1944
Notary Public

10-16-44