


STATE OF KANSAS
STATE CORPORATION COMMISSION

WELL PLUGGING RECORD

Give All Information Completely
Make Required Affidavit
Mail or Deliver Report to
Conservation Division
State Corporation Comm.
245 North Water
Wichita, KS 67202

Phillips County. Sec. 35 Twp. 3S Rge. 19 E/W
Location as "NE/CNW 1/4 SW 1/4" or footage from lines
NE NE SE

Lease Owner Petroleum Management, Inc., (PMI)
Lease Name Emma Well No. #2
Office Address 400 N Woodlawn, Suite 201 Wichita, KS. 67208
Character of Well (Completed as Oil, Gas or Dry Hole)
Dry Hole

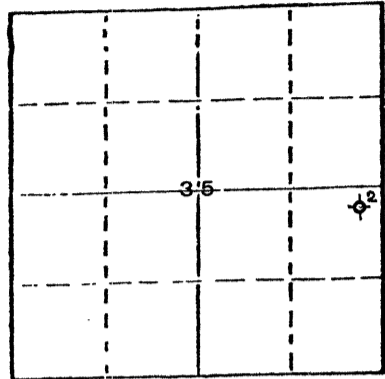

Locate well correctly on above
Section Plat

Date Well completed October 6 1978
Application for plugging filed October 6 1978
Application for plugging approved October 6 1978
Plugging commenced October 6, 6:00 P.M. 1978
Plugging completed October 6, 7:15 P.M. 1978
Reason for abandonment of well or producing formation
No Commercial Production

If a producing well is abandoned, date of last production
19

Was permission obtained from the Conservation Division or
its agents before plugging was commenced?

Name of Conservation Agent who supervised plugging of this well
Producing formation Depth to top Bottom Total Depth of Well
Show depth and thickness of all water, oil and gas formations.

OIL, GAS OR WATER RECORDS CASING RECORD

FORMATION	CONTENT	FROM	TO	SIZE	PUT IN	PULLED OUT
	surface casing	0	207'	8 5/8"	207'	0

Describe in detail the manner in which the well was plugged, indicating where the mud fluid
was placed and the method or methods used in introducing it into the hold. If cement or other
plugs were used, state the character of same and depth placed, from feet to
feet for each plug set.

- 900' with 70 sxs
- 185' with 20 sxs
- 40' with 10 sxs
- 1 sx hulls 1 wooden plug
- 100 sxs 50-50-poz with 6% gel

RECEIVED
STATE CORPORATION COMMISSION

(If additional description is necessary, use BACK of this sheet)
Name of Plugging Contractor Pioneer Drilling Company, Inc., 308 West Mill Plainville, Kansas 67663
JAN 19 1979 1-19-79
CONSERVATION DIVISION
Wichita, Kansas

STATE OF Kansas COUNTY OF Sedgwick, ss.
Dale Silcott (employee of owner) or (owner or operator)

of the above-described well, being first duly sworn on oath, says: That I have knowledge of
the facts, statements, and matters herein contained and the log of the above-described well
as filed and that the same are true and correct. So help me God.

(Signature) Dale Silcott
400 N. Woodlawn, Suite 201, Wichita, Ks.
(Address) 67208

SUBSCRIBED AND SWORN TO before me this 13th day of October, 1978

Bonnie Brown - Notary Public.

My commission expires March 1, 1981

