


15-147-00139-00-00

STATE OF KANSAS  
STATE CORPORATION COMMISSION

WELL PLUGGING RECORD

Give All Information Completely  
Make Required Affidavit  
Mail or Deliver Report to:  
Conservation Division  
State Corporation Commission  
211 No. Broadway  
Wichita, Kansas

Phillips County. Sec. 34 Twp. 3 Rge. 19W (E) (W)  
Location as "NE/CNW/SW" or footage from lines NE NE NE  
Lease Owner Sierra Petroleum Co., Inc.  
Lease Name SWISHER Well No. 1  
Office Address 208 Petroleum Bldg., Wichita, Kansas  
Character of Well (completed as Oil, Gas or Dry Hole) Dry  
Date well completed 5/3/59 19  
Application for plugging filed 5/3/59 19  
Application for plugging approved 5/3/59 19  
Plugging commenced 4/24/59 19  
Plugging completed 5/3/59 19  
Reason for abandonment of well or producing formation dry

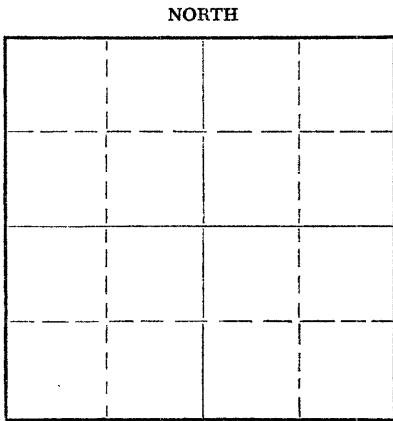

Locate well correctly on above  
Section Plat

If a producing well is abandoned, date of last production \_\_\_\_\_ 19\_\_\_\_  
Was permission obtained from the Conservation Division or its agents before plugging was commenced? yes

Name of Conservation Agent who supervised plugging of this well Eldon Petty  
Producing formation \_\_\_\_\_ Depth to top \_\_\_\_\_ Bottom \_\_\_\_\_ Total Depth of Well 3625 Feet  
Show depth and thickness of all water, oil and gas formations.

OIL, GAS OR WATER RECORDS

CASING RECORD

FORMATION	CONTENT	FROM	TO	SIZE	PUT IN	PULLED OUT
				8 5/8	194	none

Describe in detail the manner in which the well was plugged, indicating where the mud fluid was placed and the method or methods used in introducing it into the hole. If cement or other plugs were used, state the character of same and depth placed, from \_\_\_\_\_ feet to \_\_\_\_\_ feet for each plug set.

PLUGGING RECORDS

Filled hole with heavy mud from 3625 up to 600', set bridge using 1/3 sack hulls, wood plug 20 sks cement through drill pipe. Filled with mud up to 180', set bridge using 1/3 sks hulls & wood plug 15 sks cement through drill pipe. Filled with mud up to 40', set bridge using 1/3 sack hulls, wood plug, 10 sacks cement up to cellar 0. Job complete 6:45 pm 5/3/59.

RECEIVED  
STATE CORPORATION COMMISSION  
MAY 5 1959  
CONSERVATION DIVISION  
Wichita, Kansas

5-5-59

(If additional description is necessary, use BACK of this sheet)  
Name of Plugging Contractor Sierra Petroleum Co., Inc.  
Address 208 Petroleum Bldg., Wichita, Kansas

STATE OF KANSAS, COUNTY OF RUSSELL, ss.  
C. T. Honaker (employee of owner) or (owner or operator) of the above-described well, being first duly sworn on oath, says: That I have knowledge of the facts, statements, and matters herein contained and the log of the above-described well as filed and that the same are true and correct. So help me God.

(Signature) C. T. Honaker

(Address)

SUBSCRIBED AND SWORN TO before me this 4th day of May, 1959

My commission expires 1-30-61.  
Margie Cooper Notary Public.

PLUGGING  
FILE SEC 34 T. 3 R. 19W  
BOOK PAGE 35 LINE 33