

15-147-00093-00-00

STATE OF KANSAS
STATE CORPORATION COMMISSION


WELL PLUGGING RECORD

Give All Information Completely
Make Required Affidavit
Mail or Deliver Report to:
Conservation Division
State Corporation Commission
800 Biting Building
Wichita, Kansas

Phillips County. Sec. 34 Twp. 3 Rge. 19 (E) (W)

Location as "NE/CNW $\frac{1}{4}$ SW $\frac{1}{4}$ " or footage from lines C-S/2 SE SW/4
Lease Owner Sohio Petroleum Company
Lease Name Bishop Well No. #1
Office Address Russell, Kansas.
Character of Well (completed as Oil, Gas or Dry Hole) Dry Hole
Date well completed 9-25-50 19
Application for plugging filed 9-25-50 19
Application for plugging approved 9-25-50 19
Plugging commenced 9-25-50 19
Plugging completed 9-25-50 19
Reason for abandonment of well or producing formation

NORTH

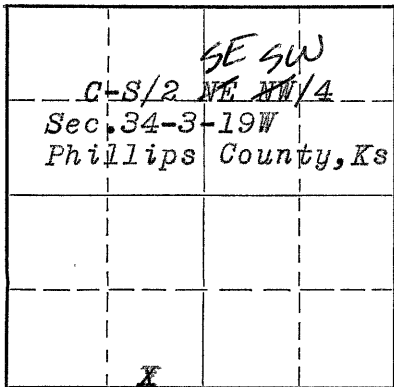

Locate well correctly on above Section Plat

If a producing well is abandoned, date of last production 19
Was permission obtained from the Conservation Division or its agents before plugging was commenced? Yes.

Name of Conservation Agent who supervised plugging of this well Elden Petty
Producing formation _____ Depth to top _____ Bottom _____ Total Depth of Well 3617 Feet
Show depth and thickness of all water, oil and gas formations.

OIL, GAS OR WATER RECORDS

CASING RECORD

Formation	Content	From	To	Size	Put In	Pulled Out
<u>Soil & shale</u>		<u>0</u>	<u>160'</u>	<u>8 5/8</u>	<u>Surface casing</u>	<u>None</u>
<u>K.C. Lime</u>		<u>3223</u>	<u>3464</u>	<u>None</u>		
<u>Arbuckle Lime</u>		<u>3566</u>	<u>3617</u>	<u>None</u>	<u>Dry Hole</u>	

Describe in detail the manner in which the well was plugged, indicating where the mud fluid was placed and the method or methods used in introducing it into the hole. If cement or other plugs were used, state the character of same and depth placed, from _____ feet to _____ feet for each plug set.

Stirred pits and filled hole with heavy mud. Placed wood plug at 155' and put 15 sacks of cement on plug through drill pipe. Filled up pipe with heavy mud and placed top wood plug at 40'. Ran 10 sacks of cement filling hole to bottom of cellar. Job completed 12:00 P.M. 9-25-50.

(If additional description is necessary, use BACK of this sheet)

Correspondence regarding this well should be addressed to Strain Drilling Co.
Address Box 188, Hays, Kansas.

STATE OF Kansas, COUNTY OF Ellis, ss.

(employee of owner) or (owner or operator) of the above-described well,
being first duly sworn on oath, says: That I have knowledge of the facts, statements, and matters herein contained and the log of the above-described well as filed and that the same are true and correct. So help me God.

(Signature) Florence Strain
Secy-Treas.
(Address)

SUBSCRIBED AND SWORN to before me this 29th day of September, 1950.

My commission expires March 1, 1954

22-7877-s 4-49-10M

PLUGGING
FILE SEC. 34 TWP. 3 R. 19W
BOOK 31 PAGE 31 LINE 31

RECEIVED
STATE CORPORATION COMMISSION
SEP 30 1950
CONSERVATION DIVISION
Wichita, Kansas
9-30-50
Notary Public.