


15-147-00053-00-00

WELL PLUGGING RECORD

Give All Information Completely
Make Required Affidavit
Mail or Deliver Report to:
Conservation Division
State Corporation Commission
800 Bitting Building
Wichita, Kansas

NORTH

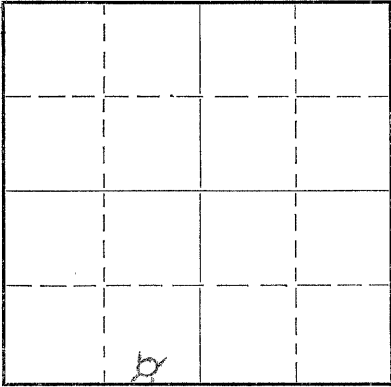

Locate well correctly on above
Section Plat

Phillips County. Sec. 34 Twp. 3 Rge. 19 (E) W (W)
Location as "NE/CNW $\frac{1}{4}$ SW $\frac{1}{4}$ " or footage from lines C-S/2 NE NW/4
Lease Owner SOHIO PETROLEUM COMPANY SE SW
Lease Name Bishop Well No. #1
Office Address Russell, Kansas.
Character of Well (completed as Oil, Gas or Dry Hole) Dry Hole
Date well completed 9-25-50 19
Application for plugging filed 9-25-50 19
Application for plugging approved 9-25-50 19
Plugging commenced 9-25-50 19
Plugging completed 9-25-50 19
Reason for abandonment of well or producing formation

If a producing well is abandoned, date of last production 19
Was permission obtained from the Conservation Division or its agents before plugging was commenced?

Name of Conservation Agent who supervised plugging of this well Elden Petty
Producing formation Depth to top Bottom Total Depth of Well 3617 Feet
Show depth and thickness of all water, oil and gas formations.

OIL, GAS OR WATER RECORDS

CASING RECORD

Formation	Content	From	To	Size	Put In	Pulled Out
Soil & shale		0	160	8 5/8"	Surface	casing none.
K.C. Lime		3223	3464	none		
Arbuckle & 2 Lime		3566	3617	none	DRY HOLE	

Describe in detail the manner in which the well was plugged, indicating where the mud fluid was placed and the method or methods used in introducing it into the hole. If cement or other plugs were used, state the character of same and depth placed, from feet to feet for each plug set.

Stirred pits and filled hole with heavy mud. Placed wood plug at 155' and put 15 sacks of cement on plug through drill pipe. Filled up pipe with heavy mud and placed top wood plug at 40' Ran 10 sacks of cement filling hole to bottom of Cellar. Job completed 12:00 P. M. 9-25-50

RECEIVED
STATE CORPORATION COMMISSION
OCT 12 1950
CONSERVATION DIVISION
Wichita, Kansas

10-12-50

(If additional description is necessary, use BACK of this sheet)

Correspondence regarding this well should be addressed to Strain Drilling Company.
Address Box 188, Hays, Kansas.

STATE OF Kansas, COUNTY OF Ellis, ss.

(employee of owner) or (owner or operator) of the above-described well, being first duly sworn on oath, says: That I have knowledge of the facts, statements, and matters herein contained and the log of the above-described well as filed and that the same are true and correct. So help me God.

(Signature)

Strain Drilling Co.
J.C. Strain
Box 188, Hays, Kansas.
(Address)

SUBSCRIBED AND SWORN to before me this 12th day of October 1950

My commission expires Jan. 31, 1953

Seward S. Greider
Notary Public.

13-147-06053-00-00

WELL LOG.

SOHIO PETROLEUM COMPANY

SE SW
C-S/2 NE NW/4
Sec. 34, T-3,
Rge-19W,
Phillips County, Ks.

Lease & well: Bishop #1
Elevation : 2061 Derrick floor.

Note : All measurements from rotary bushings.

0	5 Cellar
5	70 Clay & soil
70	160 Shale & shells
160	610 Shale & shells
610	760 Shale & shells
760	800 Sand
800	900 Shale & shells
900	1125 Shale, shells, sand
1125	1330 Sand
1330	1350 Red bed.
1350	1600 Red bed & shale
1600	1625 Shale & shells
1625	1765 Shale & shells
1765	1965 Shale & shells
1965	2000 Shale & shells
2000	2200 Shale & lime
2200	2350 Lime & shale
2350	2490 Lime & shale
2490	2605 Lime & shale
2605	2690 Lime & shale
2690	2850 Lime & shale
2850	2970 Shale & lime
2970	3050 Lime & shale
3050	3085 Lime & shale
3085	3125 Shale & Lime
3125	3150 Shale & lime
3150	3190 Lime
3190	3243 Lime
3243	3255 Lime
3255	3285 Lime
3285	3305 Lime
3305	3350 Lime
3350	3385 Lime
3385	3455 Lime
3455	3528 Lime
3528	3585 Lime & shale
3585	3617 Lime (ar buckle)
3617	T.D. (rotary bushing meas)

COMMENCED: 9-16-50
COMPLETED: 9-25-50

CASING RECORD:

8 5/8" Surface casing set at 160'
w/100 sacks cement by Globe
Cementing co.

D.S.T. by Johnson Testing Co.

3224' to 3243' tool open 1 hr.
recovered 15 feet drilling mud,
6 min. weak blow. B. H.P. 15 min
0.

3276' to 3285' Tool open 1 Hr.
8 min, weak blow. Recovered
2 gallon free oil, 15 feet oil
and gas cut mud. B. H. P. 10 min.
750#.

Ran Schlumberger log and Micro
log, run to total depth.

RECEIVED
STATE CORPORATION
OCT 12 1950
CONSERVATION DIVISION
Wichita, Kansas
10-12-50

TOPS:

Anhydrite	1600	Base Lansing (K.C.)	3464
Heebner	3200	Ar buckle	3566
Brown Lansing	3223	Total Depth	3617
White Lansing (K.C.)	3241		

I hereby affirm that the above and foregoing is a true and correct copy of the log of the Bishop #1, located C-S/2 NE NW/4 of Sec. 34, T-3, Rge-19W, Phillips County, Kansas.

Contractor: Strain Drilling Company.

By T.C. Strain
T.C. Strain.