


Give All Information Completely  
 Make Required Affidavit  
 Mail or Deliver Report to:  
 Conservation Division  
 State Corporation Commission  
 800 Bitting Building  
 Wichita, Kansas

OR  
**FORMATION PLUGGING RECORD**

Strike out upper line  
 when reporting plug-  
 ging off formations.

NORTH

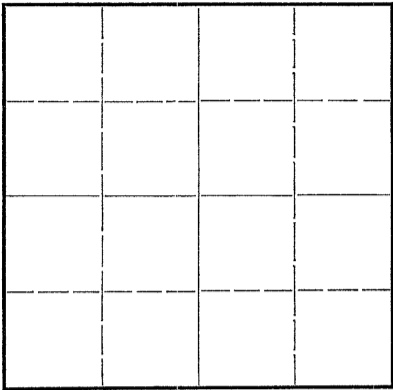

Locate well correctly on above  
 Section Plat

Norton County. Sec. **36** Twp. **3** Rge. **(E) 23** (W)  
 Location as "NE $\frac{1}{4}$ NW $\frac{1}{4}$ SW $\frac{1}{4}$ " or footage from lines **NW/4**  
 Lease Owner **Phillips Petroleum Company**  
 Lease Name **Myra** Well No. **1**  
 Office Address **Bartlesville, Oklahoma**  
 Character of Well (completed as Oil, Gas or Dry Hole) **Dry Hole**  
 Date well completed **7-11-1944**  
 Application for plugging filed **7-11-1944**  
 Application for plugging approved **7-11-44**  
 Plugging commenced **7-11-1944**  
 Plugging completed **7-11-1944**  
 Reason for abandonment of well or producing formation **Dry Hole**

If a producing well is abandoned, date of last production \_\_\_\_\_ 19\_\_\_\_  
 Was permission obtained from the Conservation Division or its agents before plugging was com-  
 menced? **Yes**


Name of Conservation Agent who supervised plugging of this well **Eldon Petty**  
 Producing formation **None** Depth to top \_\_\_\_\_ Bottom \_\_\_\_\_ Total Depth of Well **3732 $\frac{1}{2}$**  Feet

Show depth and thickness of all water, oil and gas formations.  
 OIL, GAS OR WATER RECORDS CASING RECORD

Formation	Content	From	To	Size	Put In	Pulled Out
Topeka	Dry	3237		13 3/8"	243'	None
Lansing Kansas City	Dry	3454	3662'			
Weathered Granite	Dry	3705	3732 $\frac{1}{2}$ '			

Describe in detail the manner in which the well was plugged, indicating where the mud fluid was placed and the method or methods used in introducing it into the hold. If cement or other plugs were used, state the character of same and depth placed, from \_\_\_\_\_ feet to \_\_\_\_\_ feet for each plug set.

Filled with mud from 3732 $\frac{1}{2}$ ' to 247'. Set wood plug at 247' and then ran 20 sacks of cement and filled with mud to 28'. Set wood plug at 28' and ran 15 sacks of cement in filling to base of cellar.

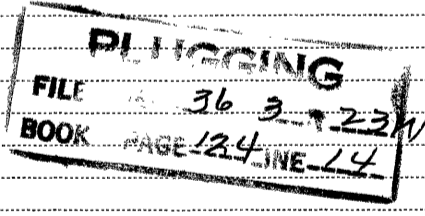

(If additional description is necessary, use BACK of this sheet)

Correspondence regarding this well should be addressed to **Mr. Ralph McKnight**  
 Address **Box 528-Russell, Kansas**


STATE OF **Kansas**, COUNTY OF **Russell**, ss.  
**Ralph McKnight** (employee of owner) or (owner or operator) of the above-described well,

being first duly sworn on oath, says: That I have knowledge of the facts, statements, and matters herein contained and the log of the above-described well as filed and that the same are true and correct. So help me God.

(Signature) *Ralph McKnight*  
**Box 528 - Russell, Kansas**  
 (Address) **20 44**

SUBSCRIBED AND SWORN to before me this **18th** day of **July**, 19 **44**

My Commission Expires **June 14, 1948**  
 My commission expires \_\_\_\_\_

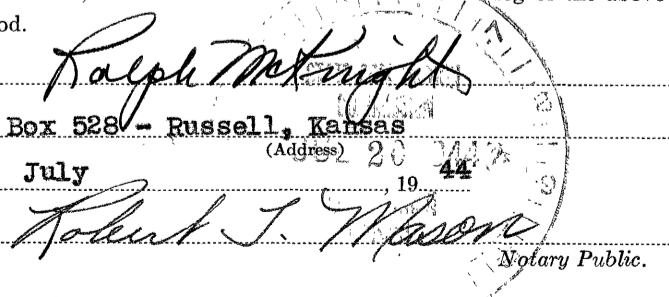

7-20-44

## Formation Record

Lease **Myra**

15-137-00019-00-00

Well No. **1**

FROM	TO	Formation	REMARKS
0	20	Surface Soil	<u>Elevation 2360' D.F.</u>
20	40	Sandy Lims	
40	245	Sand	
245	490	Shale	
490	550	Lime	
550	670	Sandy Shale	
670	860	Shale & Shells	
860	1315	Sand, Shale, Shells, Iron Pyrite	
1315	1375	Sand	
1375	1700	Shale & Shells	
1700	1940	Shale	
1940	1974	Anhydrite	
1974	2145	Shale & Shells	
2145	2165	Lime, Shale, & Iron Pyrite	
2165	2450	Shale & Shells	
2450	2508	Lime & Shale	
2508	2597	Lime & Iron Pyrite	
2597	2605	Shale	
2605	2855	Lime & Shale	
2855	2900	Lime	
2900	3289	Lime & Shale	Top Topeka 3237' D.F.-No Shows.
3289	3292	Iron Pyrite	
3292	3295	Lime	
3295	3297	Iron Pyrite	
3297	3316	Cherty Lime	
3316	3397	Sandy Lime	
3397	3495	Lime & Shale	Top LKC 3454' D.F.-No Shows.
3495	3523	Shale & Cherty Lime	
3523	3663	Lime & Shale	Base LKC 3662' D.F.-No Shows.
3663	3669	Sandy Lime	
3669	3707	Lime & Shale	Top Weathered Granite 3705' D.F. No shows.
3707	3732 $\frac{1}{2}$	Granite Wash	Total Depth 3732 $\frac{1}{2}$ ' D.F. (D & A)

<b>PLUGGING</b>	
FILE	36 3-23W
BOOK	PAGE 124 LINE 14

7-20-44